



**ROCKFORD BOARD OF EDUCATION  
INVITATION FOR BID ON SUPPLIES, MATERIALS, EQUIPMENT OR SERVICES  
FOR SCHOOL DISTRICT NO. 205  
ROCKFORD, ILLINOIS**

IFB No.        **IFB No. 22-49 Administration Building Lower-Level Renovations**

DATE:        **May 4, 2022**

RE:        **ADDENDUM NO. 1**

---

To All Bidders:

Included are modifications, clarifications and/or corrections for the Project Manual and are hereby made a part of the contract documents. Please attach this addendum to the Project Manual(s) in your possession. Please note the receipt of this addendum on the bid form. Bidders shall review changes to all portions of this work as changes to one portion may affect the work of another.

**If you plan to hand deliver your IFB submission on the due date, please note you must check in on the 1st floor prior to coming to the bid opening. Please allow time for this as late submission will not be accepted.**

Refer all questions relative to the business aspect, Instructions to Bidders, Special Conditions, and questions concerning the technical aspect of the documents to the Director of Purchasing by email at [purchasingdeptstaff@rps205.com](mailto:purchasingdeptstaff@rps205.com).

ROCKFORD BOARD OF EDUCATION

By: Dane Youngblood  
Director of Purchasing

ADMINISTRATION BUILDING BASEMENT RENOVATION  
ROCKFORD PUBLIC SCHOOLS 205  
ROCKFORD, ILLINOIS

**LARSON & DARBY GROUP**

4949 Harrison Avenue, Suite 100  
815/484-0739

**ARCHITECTURE-ENGINEERING-INTERIORS**

Rockford, IL 61108  
FAX 815.229.9867

TO: ALL BIDDERS

RE: ADDENDUM #1

Changes to Bidding Documents Dated April 13, 2022

PROJECT: ADMINISTRATION BUILDING BASEMENT RENOVATION  
ROCKFORD PUBLIC SCHOOLS 205  
ROCKFORD, ILLINOIS

PROJECT NO.: RPS IFB 22-49, RPS PROJECT NO. 2112  
LDG PROJECT 30186


DATE: May 4, 2022

Please attach this Addendum to the Project Manual and Drawings for the referenced project. Take the changes to the Project Manual and Drawings into consideration in preparing your Bid.

Bidders shall make note in writing on Bid Form that this Addendum has been taken into consideration. Failure to do so may be sufficient cause to reject the Bid.

LARSON & DARBY GROUP

By

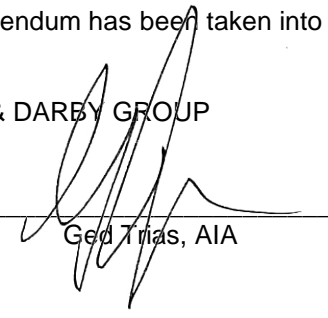  
Geo Trias, AIA

This Addendum consists of 1 page, plus materials itemized herein.

I. PRE-BID CONFERENCE

- A. Pre-Bid Conference Opening Statement is issued herewith
- B. Minutes of the Pre-Bid Conference dated April 28, 2022 are issued herewith.
- C. Pre-Bid Conference Attendance Record, 2 pages, is issued herewith.

II. GENERAL CLARIFICATIONS

- A. Scranton Products submitted a request to substitute Scranton HDPE toilet partitions in lieu of specified metal toilet partitions. This proposed substitution is rejected.

III. ADDITIONS OR CHANGES TO THE DRAWINGS:

REISSUED DRAWINGS: The following revised Drawings, which replace previous issues of the Drawings, are issued herewith:

A1.1, ED1.1, E2.1.

END OF ADDENDUM #1

## PRE-BID CONFERENCE OPENING STATEMENT

Welcome to the mandatory pre-bid conference for IFB No. 22-49 Administration Building Lower-Level Renovations for the Rockford Public Schools.

The purpose of this meeting is to receive input, comments, questions, clarifications and suggested changes relative to this solicitation. As a reminder, the only acceptable changes to the Bid/RFP are formal Addenda published by the RPS Purchasing department. Additionally, the Addendum may address other issues identified by the School District.

The goal of today's meeting is to increase your knowledge of the solicitation as it is written and provide an information mechanism in which you may advise the School District of any changes it should make. Consequently, any changes you wish the Rockford Public Schools to consider must be submitted in writing to the Purchasing department before the deadline as expressed in the solicitation.

We will try to answer as many of the questions as possible. If we cannot answer a question today, we will defer that answer to the published Addendum. Additionally, minutes from this pre-bid conference will be published in the Addendum.

- Bid Opening is scheduled for May 12, 2022 at 2:00 pm Rockford Board of Education, 6th floor Conference Room. Late bids will not be accepted. Faxed or emailed bids will not be accepted.
- Board Approval May 24, 2022.
- Bid RFI Procedures - All written correspondence during the bid process **MUST** be sent to Dane Youngblood, Director of Purchasing, via email at [PurchasingDeptStaff@rps205.com](mailto:PurchasingDeptStaff@rps205.com). Last RFI will be accepted until May 3, 2022 at 12 pm. Last addendum will be issued by May 5, 2022 at 4:30 pm.
- Addenda will be emailed to all attendees at the pre-bid conference, posted on the RPS website and Bonfire.
- PLEASE reference the **REQUIRED FORMS CHECK LIST** for all documents that **must** be submitted with your bid offer form. All forms must be properly completed, signed and submitted or your bid will be deemed non-responsive.



**MEMORANDUM of PRE-BID MEETING**

TO: Chris Liska (CL)  
RPS Construction Project Manager

CC: Ged Trias (GT)  
Julie A. Williams (JW)  
Project file

DATE: April 28, 2022

RE: RPS Admin Bld Renovations-Basement Renovations  
Pre-Bid Meeting-onsite  
LDG Project #30186

FROM: Julie A. Williams

1. Chris Liska opened the meeting by welcoming the attendees and introducing the design team as:
  - a. Chris Liska-RPS representative
  - b. Ged Trias, Larson & Darby Group
  - c. Julie Williams, Larson & Darby Group
2. Chris read the Pre-Bid Conference Opening Statement (see attached) which outlines the bid schedule and expectations then turned it over to Ged.
3. GT: Project overview:
  - a. RPS wishes to renovate the Basement level to accommodate the Special Ed Programs that once were located at the Page Park School.
  - b. Alternate 1 scope includes the Storage area and adjacent rooms as shown on the drawings.
  - c. Coordination with RPS elevator modernization project will need to be addressed.
    - i. The elevator project has yet to go out to bid
4. JW: Described finishes involved as per RPS standards with only change that new LVT at 5mm thickness in lieu of 2.5mm as previous standard.
5. CL: Expect to start project immediately after award of bid.
  - a. Move quickly with submittals
  - b. Identify long lead items
  - c. RPS realizes the situation with current market and leadtimes
6. JW: Submittal process is as described in specs: (3) of each type, product data, samples and shop drawings. Allows for a copy for LDG, RPS and GC. Ideally all together in one submittal. If unable to, follow up quickly with subsequent submittals.
7. CL asked for questions?
8. Following questions were asked:

Q: What is schedule?

A: Commencement: Work to begin immediately after award of bid.  
Final completion: Before start of school on September 1<sup>st</sup>, 2022  
Substantial completion: end of August 2022

Q: What is budget?

A: RPS does not share budget information

Q: Hours of work?

A: Work to be done during normal business hours. Some exceptions may be made for special accommodations as decided and agreed upon during course of construction.

Q: Concern for noise levels at Registration?

A: RPS has no concern about noise levels

Q: How do we access the jobsite?

A: RPS to coordinate areas of use. Service elevator will be available as well as both stairwells

Q: What is the coordination with the Elevator modernization work?

A: Coordination will be with piping

Q: Is there special demo for removing the hood? Are controls tied to fire alarms?

A: RPS to determine and advise

Q: What about the serving counter?

A: Serving counter is part of demo.

9. CL stated that this is 100% Contract work. RPS is not involved in any construction on this project.

10. CL stated this is not a Federal project.

11. CL adjourned meeting, thanking the attendees and advising attendees conduct a walk through on their own.

END

The foregoing constitutes our understanding of the matters discussed and conclusions reached. Other participants are requested to review and advise the undersigned, in writing, of any omissions or different understandings they may have.



ROCKFORD PUBLIC SCHOOLS  
IFB No. 22-49 Administration Building Lower-Level Renovations  
Pre-Bid Meeting Sign-In Sheet  
April 26, 2022 at 10:00 a.m.

PRE-BID MEETING SIGN-IN SHEET

IFB No. 22-49 Administration Building Lower-Level Renovations

PLEASE WRITE EMAIL ADDRESS SO THAT IT IS LEGIBLE IN ORDER TO RECEIVE ADDENDUM INFORMATION

	Printed Name	Company Name	Company Address	Telephone	E-mail
1	Chris J. Liszka RPS205 Construction Project Manager 5052 28th Ave., Rockford IL 61109 P: 815-378-3632 christopher.liszka@rps205.com				
2					
3	Brett Bauer	Rinaldo Johnson	1725 HUNTERWOOD	779-970-4980	estimating@rjngland.com
4	Tom McNamers	Henson & Henson Builders	5612 Industrial Ave	815-979-0991	Estimating@LBuilders.net
5	Alberto Danderos	Antigua Lim.	3604 N. Lakeview Ave Chicago	708-490-5311	alanderos@antiguac.com
6	Jeff Bocklop	Stenstrom	2420 20th St Rockford IL 61104	815-398-2420	jeffb@stenstrom.com
7	Murresh Sanderi	Sanderi Dens	Harrison Avenue, IL 61106	815 979 9769	msanderi@stenstromconstruction.com

ROCKFORD PUBLIC SCHOOLS  
IFB No. 22-49 Administration Building Lower-Level Renovations  
Pre-Bid Meeting Sign-In Sheet  
April 26, 2022 at 10:00 a.m.

8					
	Printed Name	Company Name	Company Address	Telephone	E-mail
9	<del>Tony Ammerberg</del>	<del>Rockford Structures</del>	10540 W. 2nd St.	815-633-6161	<del>tony@rockfordstructures.com</del>
10	<del>Nate Boas</del>	<del>Beckmark</del>	8197 Commerce Dr	815-925-6859	
11	Kevin Heuer	Special Power	1226 18th Ave	815-962-1210	Kevin@specialpower.com
12	Jeff Flanders	McDermid's	Kirkwood St	715-218-2420	mcd@mcdmids.com
13	Andrew Copeland	Miller Engineering	1616 S main	815-298-5307	andrew.c@mcgroup.com
14	Julie Williams	LDG	4949 Harrison Ave	815-418-1039	jwilliams@ldg.com
15	GEO TRAS	"	"	"	gtrias@arsondarb.com
16					
17					
18					
19					

## PRE-BID CONFERENCE OPENING STATEMENT

Welcome to the mandatory pre-bid conference for IFB No. 22-49 Administration Building Lower-Level Renovations for the Rockford Public Schools.


The purpose of this meeting is to receive input, comments, questions, clarifications and suggested changes relative to this solicitation. As a reminder, the only acceptable changes to the Bid/RFP are formal Addenda published by the RPS Purchasing department. Additionally, the Addendum may address other issues identified by the School District.

The goal of today's meeting is to increase your knowledge of the solicitation as it is written and provide an information mechanism in which you may advise the School District of any changes it should make. Consequently, any changes you wish the Rockford Public Schools to consider must be submitted in writing to the Purchasing department before the deadline as expressed in the solicitation.

We will try to answer as many of the questions as possible. If we cannot answer a question today, we will defer that answer to the published Addendum. Additionally, minutes from this pre-bid conference will be published in the Addendum.

- Bid Opening is scheduled for May 12, 2022 at 2:00 pm Rockford Board of Education, 6th floor Conference Room. Late bids will not be accepted. Faxed or emailed bids will not be accepted.
- Board Approval May 24, 2022.
- Bid RFI Procedures - All written correspondence during the bid process **MUST** be sent to Dane Youngblood, Director of Purchasing, via email at [PurchasingDeptStaff@rps205.com](mailto:PurchasingDeptStaff@rps205.com). Last RFI will be accepted until May 3, 2022 at 12 pm. Last addendum will be issued by May 5, 2022 at 4:30 pm.
- Addenda will be emailed to all attendees at the pre-bid conference, posted on the RPS website and Bonfire.
- PLEASE reference the **REQUIRED FORMS CHECK LIST** for all documents that **must** be submitted with your bid offer form. All forms must be properly completed, signed and submitted or your bid will be deemed non-responsive.



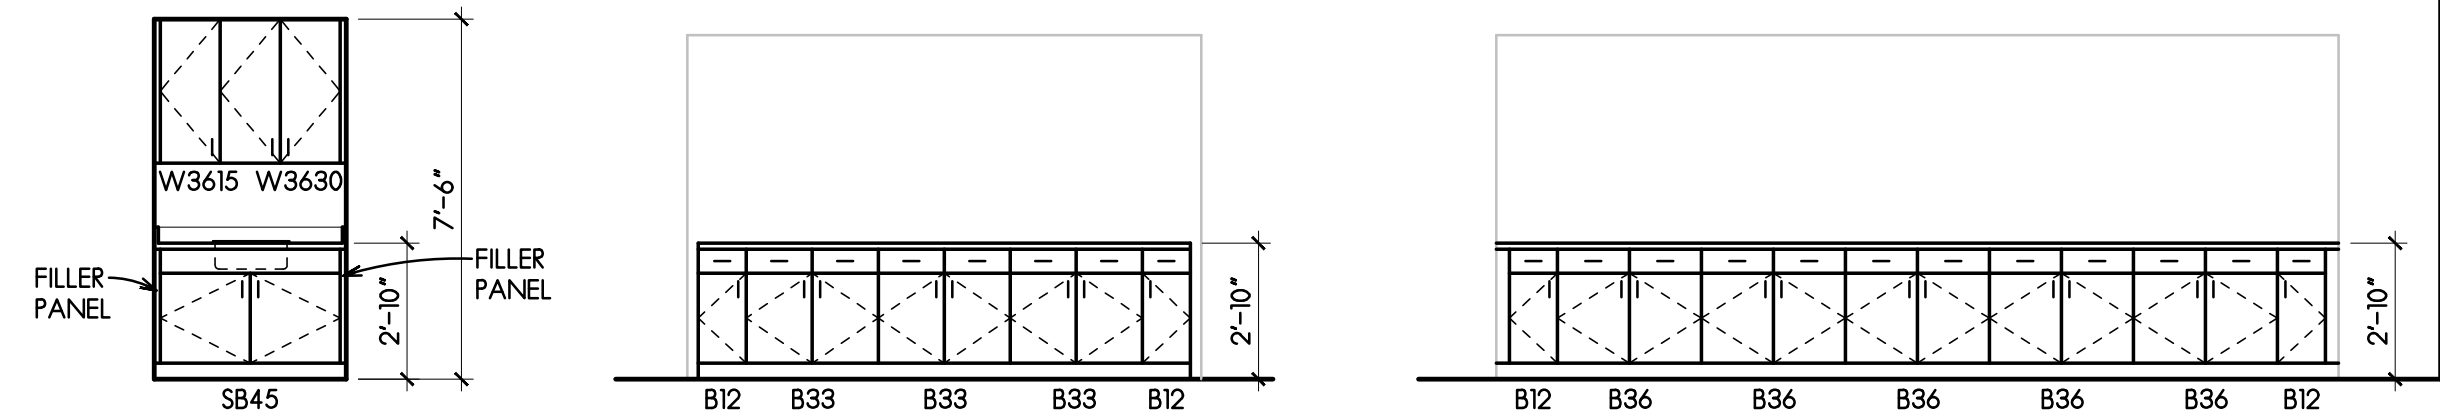

LUNCH  
028 - EAST


SCALE: 1/4" = 1'-0"

LOBBY 030 - WEST

SCALE: 1/4" = 1'-0"

LOBBY 030 - SOUTH


SCALE: 1/4" = 1'-0"

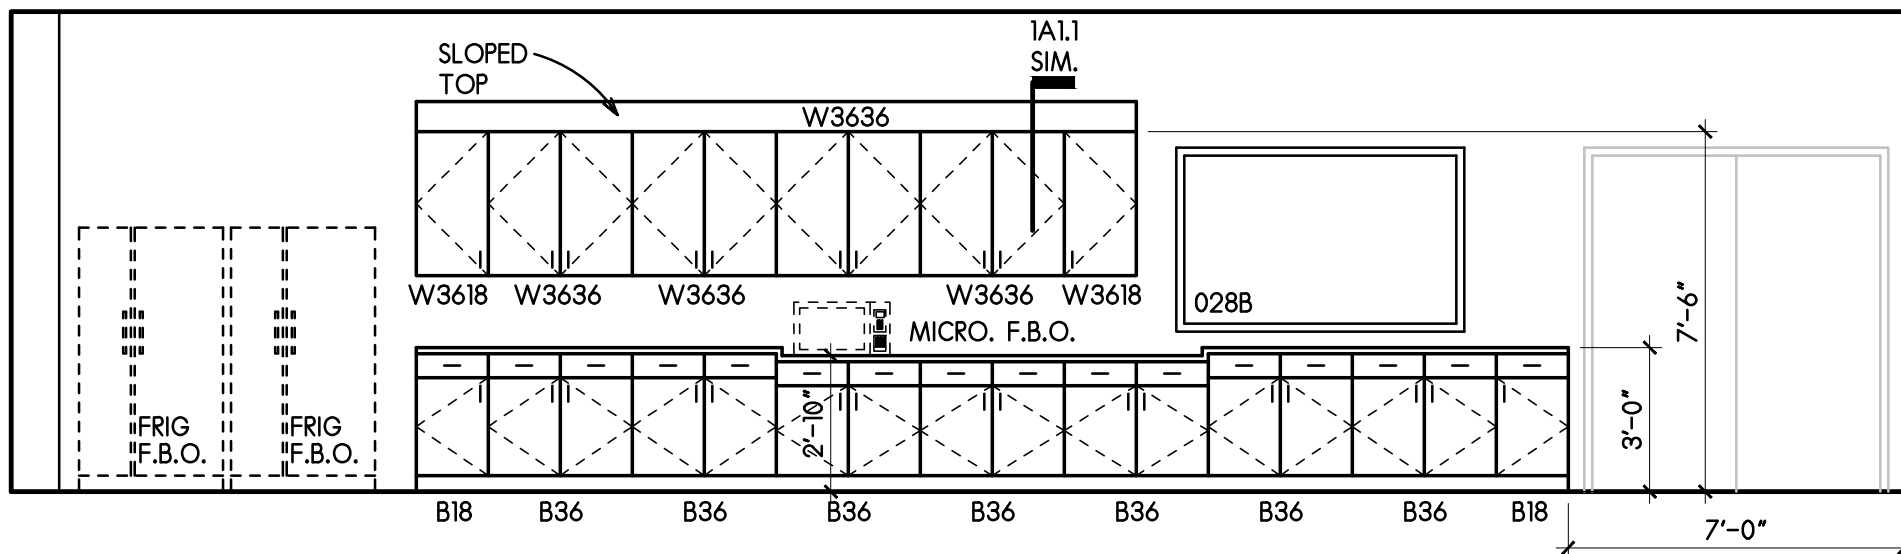

LUNCH 028 - NORTH


SCALE: 1/4" = 1'-0"

CABINETS TO HAVE PLASTIC LAMINATE FINISH ON ALL EXPOSED SURFACES  
WITH SOLID SURFACE COUNTERTOPS AND MALAMINE FINISH ON ALL  
INTERIOR SURFACES PER RPS STANDARDS

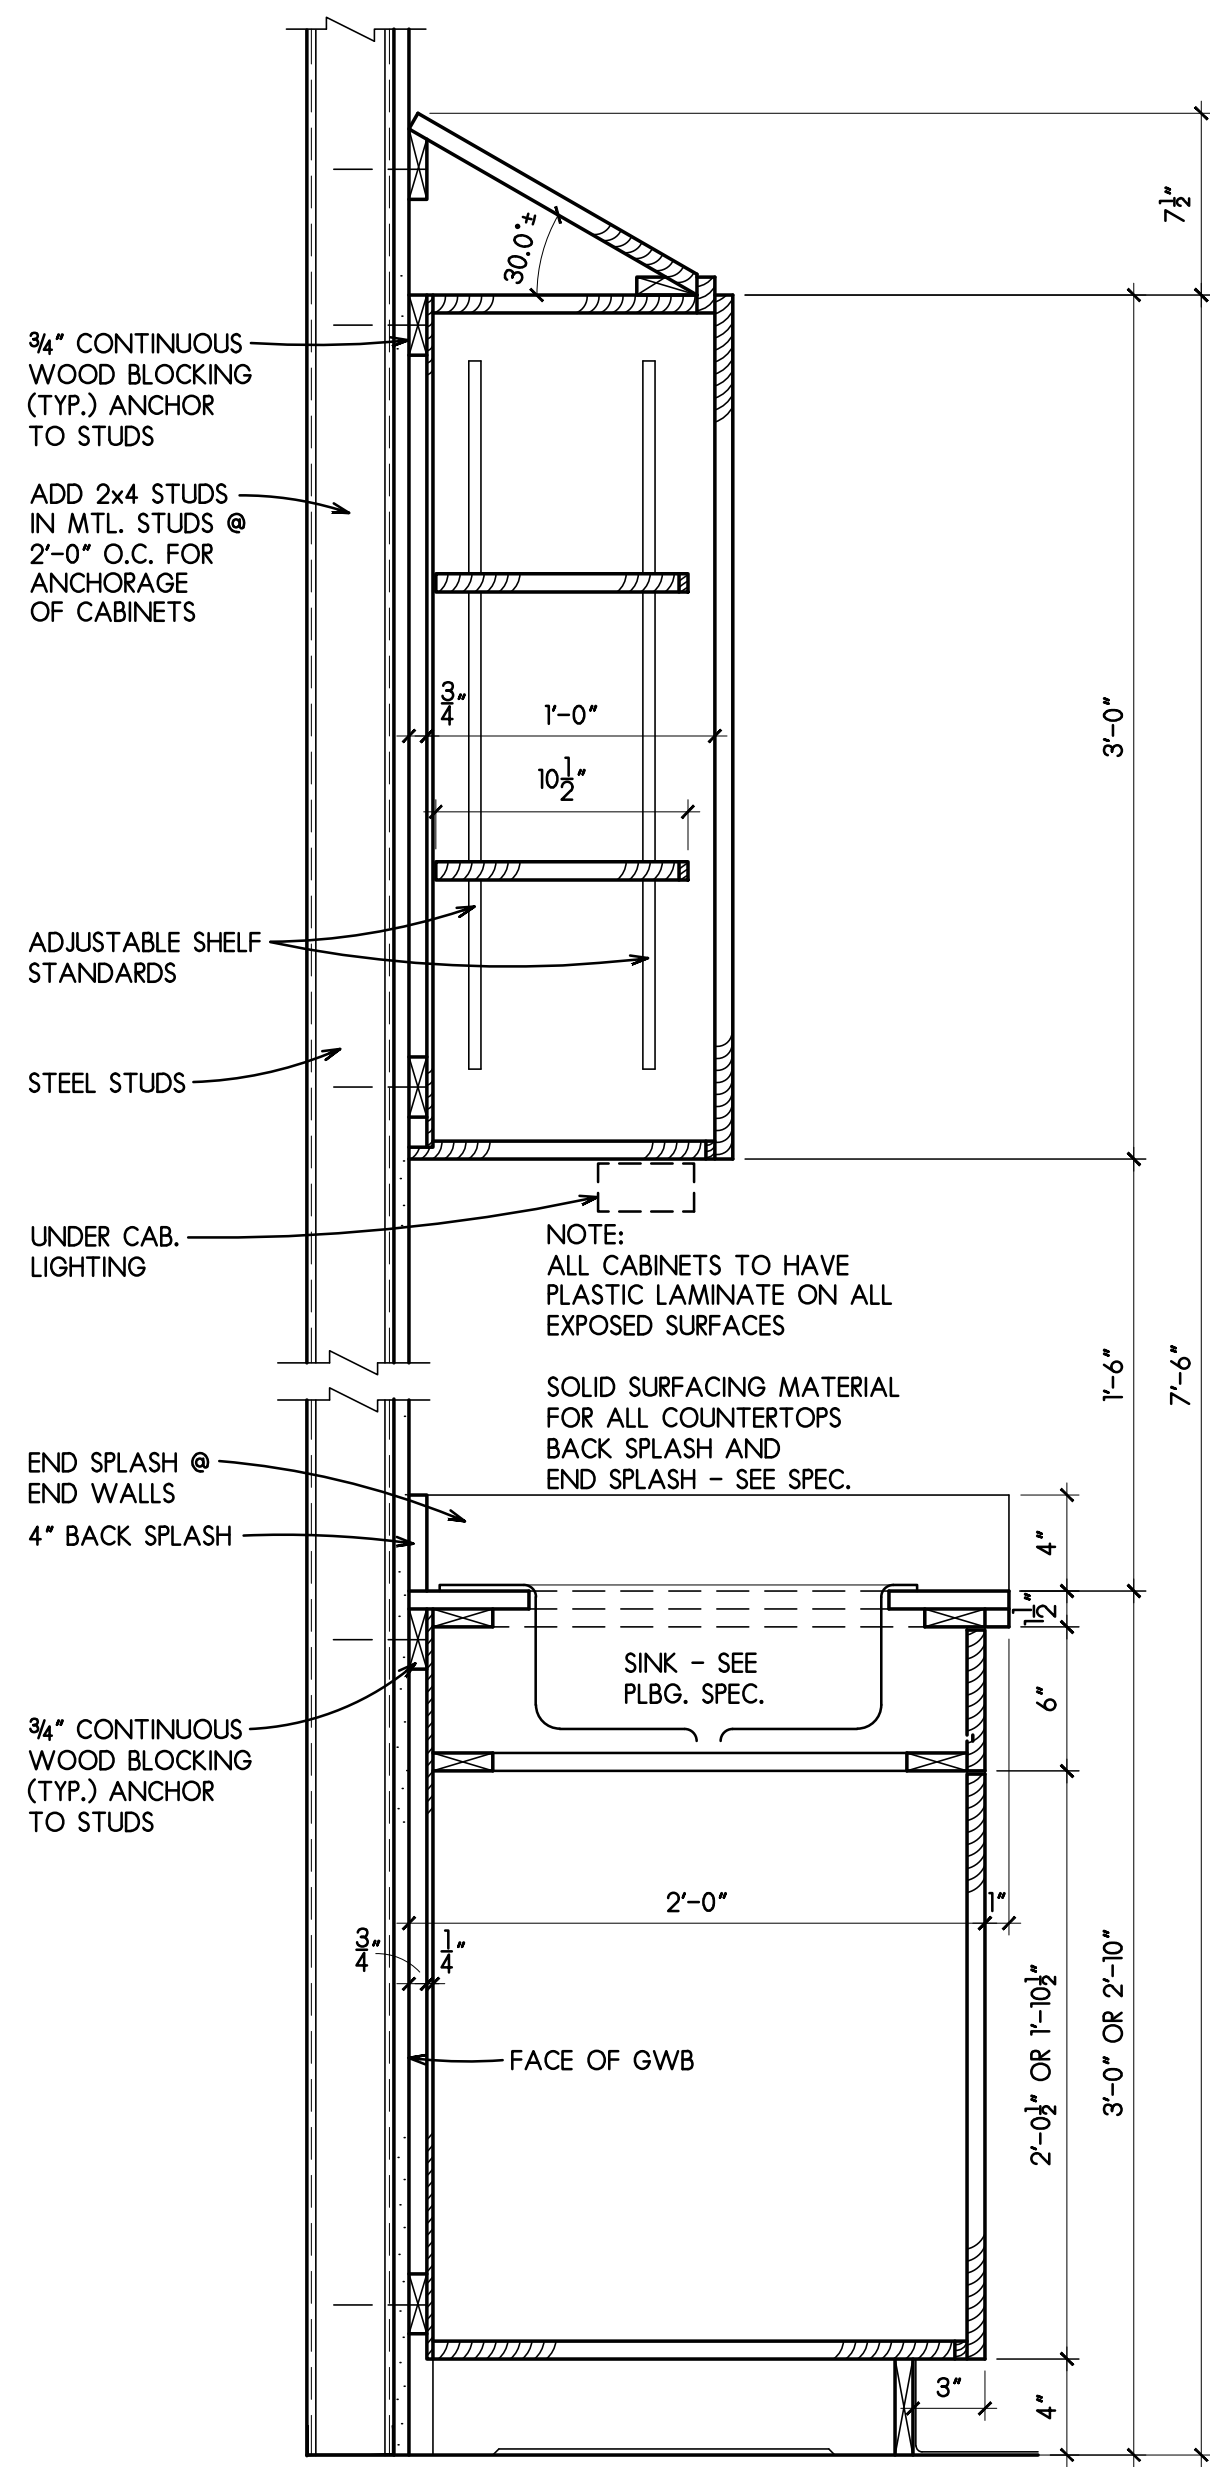

1 CABINET SECTION


SCALE: 1 1/2" = 1'-0"

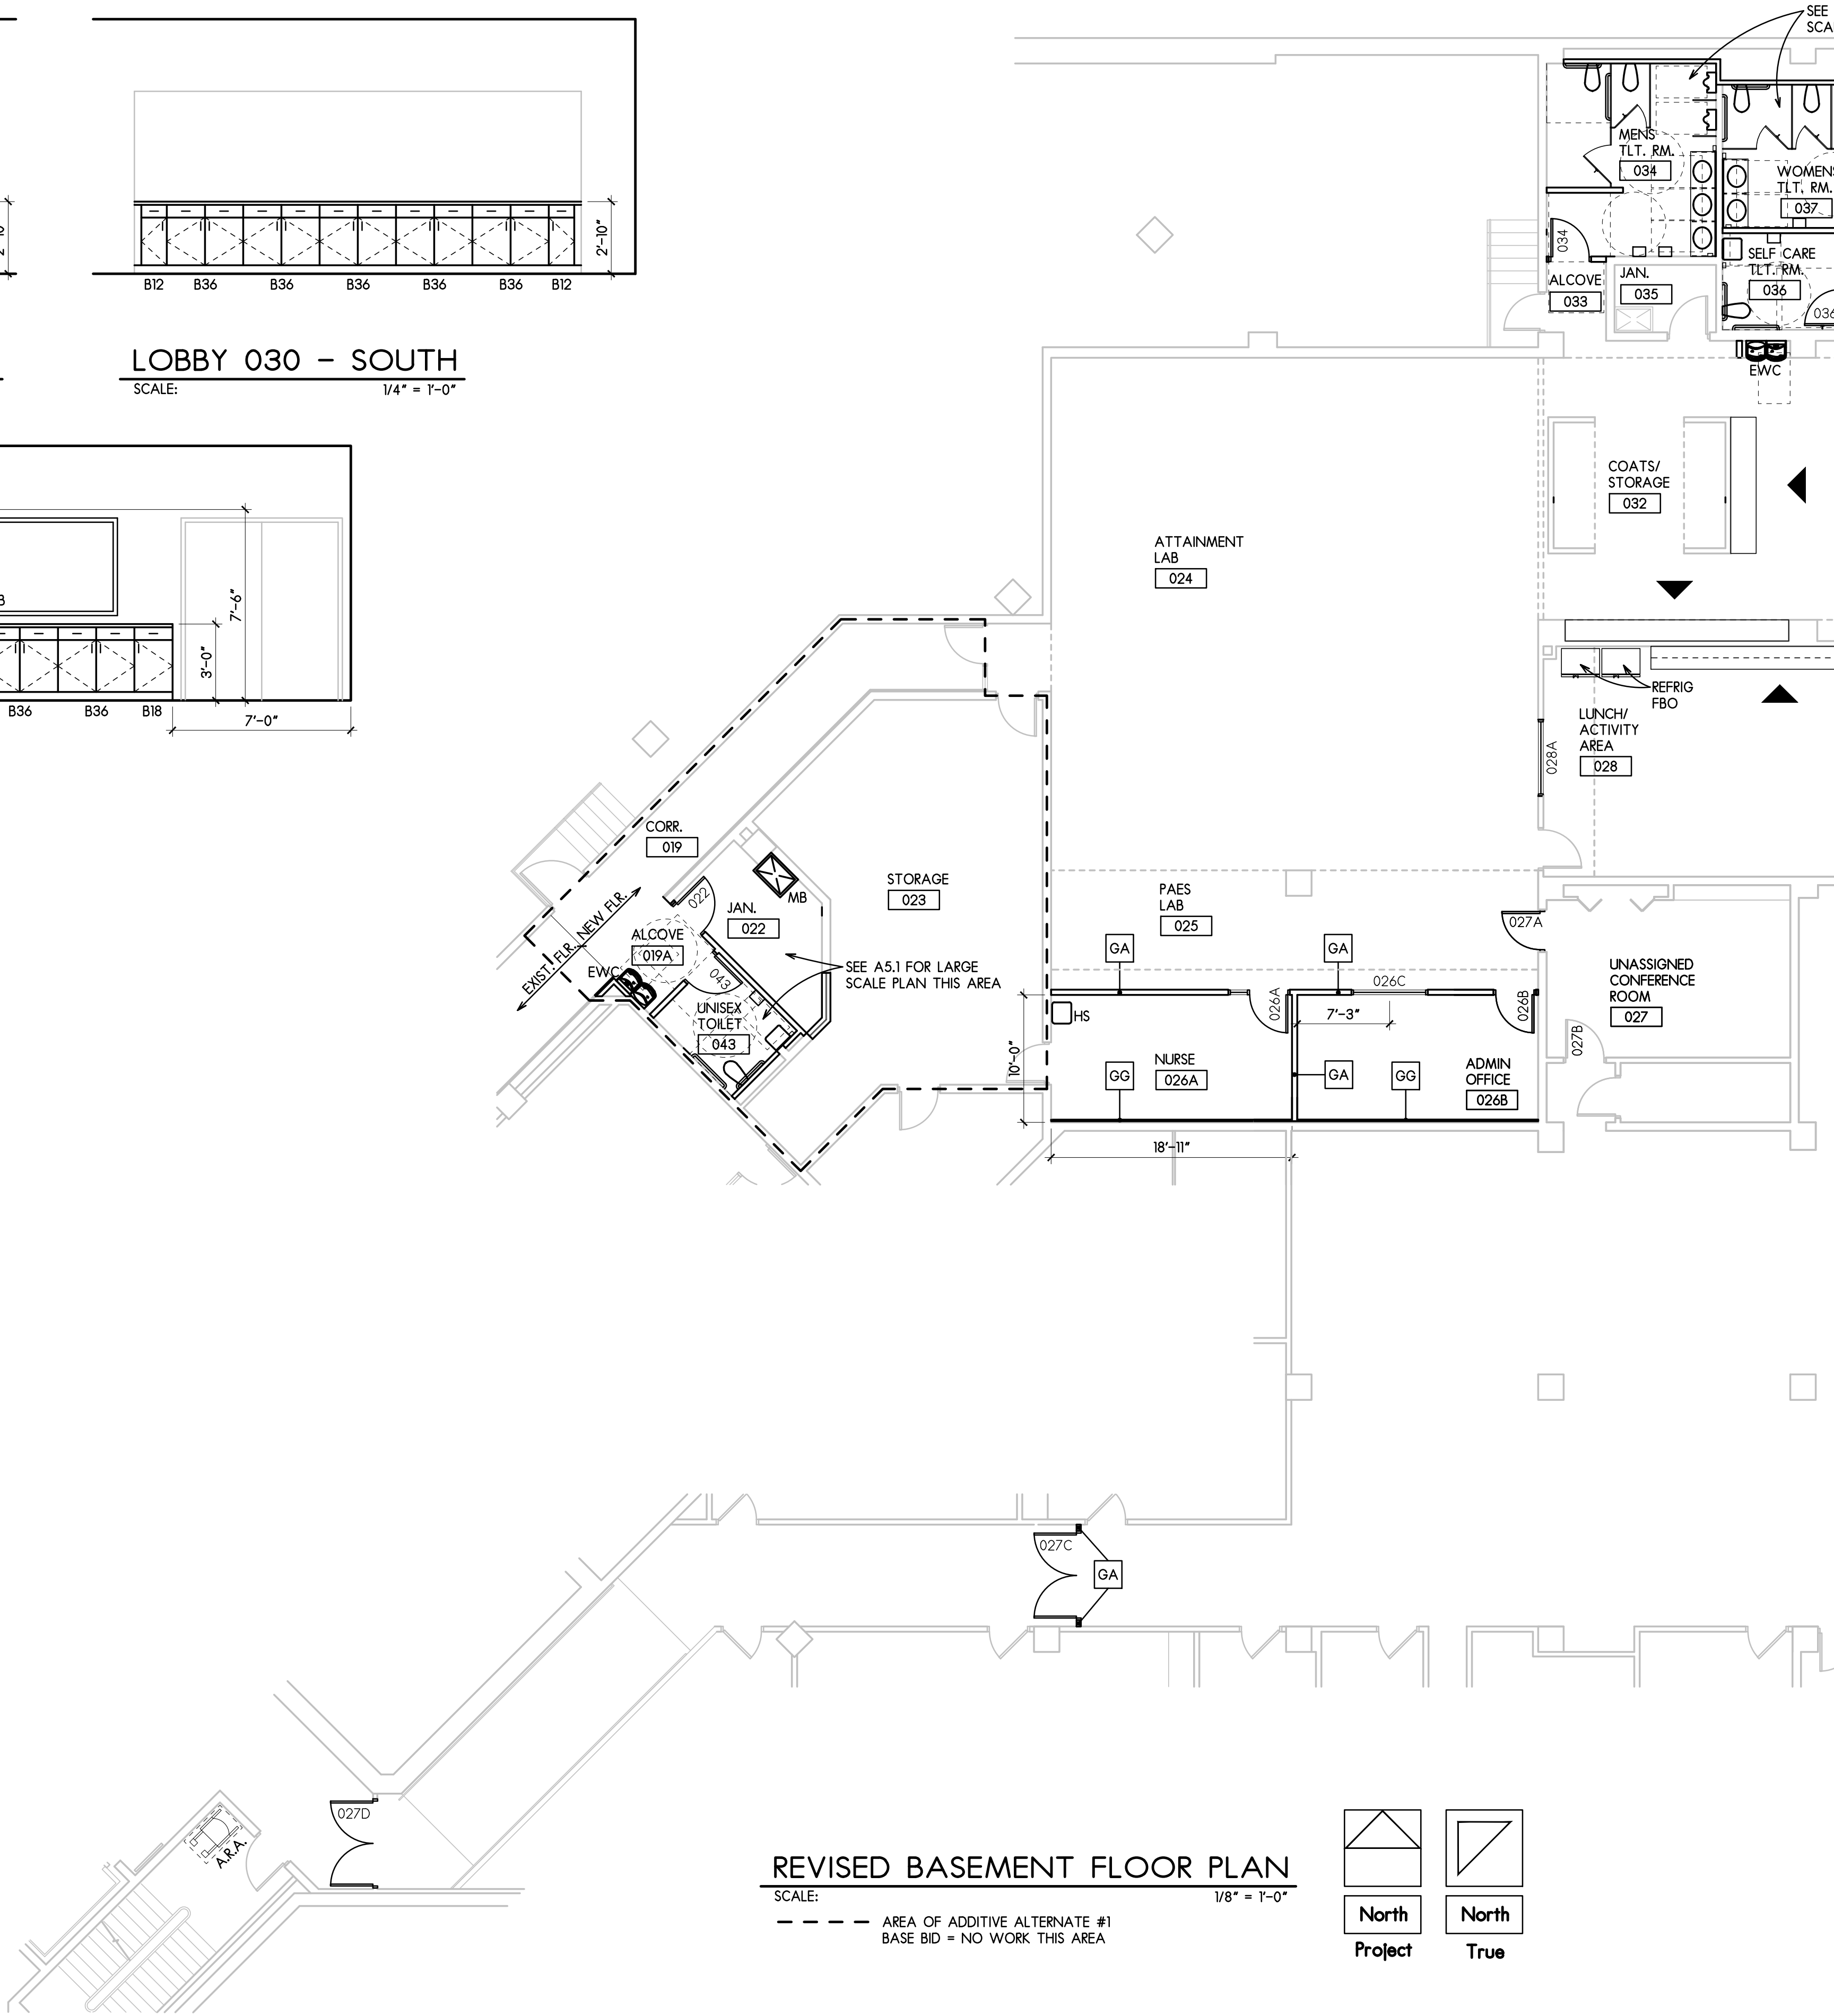

REVISED BASEMENT FLOOR PLAN

SCALE: 1/8" = 1'-0"

--- AREA OF ADDITIVE ALTERNATE #1  
BASE BID = NO WORK THIS AREA

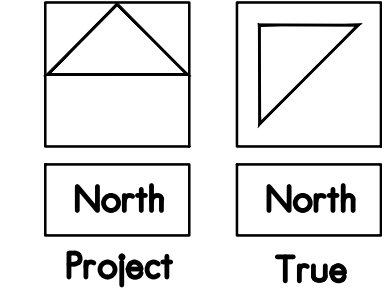

WALL TYPES :

- GA 5/8" GWB BOTH SIDES OF 362S125-30 METAL STUDS @ 16" O.C. TO 6" ABOVE CEILING W/ SOUND BATT INSULATION FULL HEIGHT
- GB 5/8" GWB BOTH SIDES OF 362S125-30 METAL STUDS @ 16" O.C. TO 6" ABOVE CEILING
- GC 5/8" MOLD AND MOISTURE RESISTANT GWB BOTH SIDES OF 362S125-30 METAL STUDS @ 16" O.C. TO 6" ABOVE CEILING W/ SOUND BATT INSULATION
- GD 5/8" GWB BOTH SIDES OF 362S125-30 METAL STUDS @ 16" O.C. TO 6" ABOVE HIGHEST CLG. - PROVIDE MOLD AND MOISTURE RESISTANT GWB IN ALL WET WALL LOCATIONS
- GE 5/8" GWB ONE SIDE OF 362S125-30 METAL STUDS @ 16" O.C. TO 6" ABOVE HIGHEST CLG. - PROVIDE MOLD AND MOISTURE RESISTANT GWB IN ALL WET WALL LOCATIONS
- GF 5/8" GWB BOTH SIDES OF 362S125-30 METAL STUDS @ 16" O.C. TO 6" ABOVE HIGHEST CLG. W/ SOUND BATT INSULATION FULL HEIGHT - PROVIDE MOLD AND MOISTURE RESISTANT GWB IN ALL WET WALL LOCATIONS
- GG 5/8" GWB ONE SIDE OF 7/8" FURRING CHANNELS AT 16" O.C. HORIZONTALLY TO 6" ABOVE CEILING

GENERAL NOTES :


- G.C. TO COORDINATE WITH THE ELECTRICAL CONTRACTOR FOR LOCATIONS OF ALL FLOOR BOXES THAT WILL NEED TO BE CUT INTO THE EXISTING FLOOR SLAB - G.C. RESPONSIBLE FOR ALL CUTTING AND PATCHING.
- G.C. TO COORDINATE WITH THE ELECTRICAL CONTRACTOR FOR LOCATIONS OF ALL ELECTRICAL IN-WALL RECEPTACLES / DEVICES - G.C. RESPONSIBLE FOR ALL PATCHING OF WALLS WHEN ELECTRICAL INSTALLATION IS COMPLETE.

KEYNOTES :

- CM - CASEWORK/MILLWORK
- EW - ELECTRIC WATER COOLER
- HS - HAND SINK
- MP - MOP BASIN
- NIC - NOT IN CONTRACT

REVISED  
BASEMENT FLOOR PLAN


SCALE: 1/8" = 1'-0"

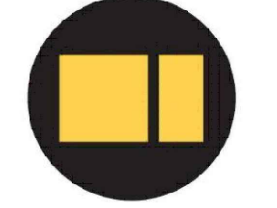

ISSUED FOR:	DATE	PROJECT NUMBER	SHEET NUMBER
ADDENDUM 1	05-04-22	30186	A1.1
APPROVED:	CHK'D:	DRWN:	
GT	PAW	JWI	



FILE: F:\788-E\21E\788E2 E2.1.DWG SAVED BY: RCAMARENA DATE: 5/3/2022 TIME: 2:56 PM

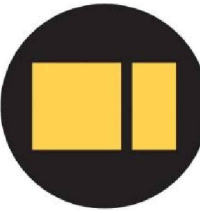

AN ADMIN. BASEMENT RENOVATION FOR:  
**RPS DISTRICT 205** IFB 22-49 P2112  
501 7TH ST. ROCKFORD, ILLINOIS 61104

COPYRIGHT 2022  
All drawn and written information appearing herein shall not be duplicated, disclosed, or otherwise used without the written consent of  
**Larson & Darby Group**

ISSUED FOR:	DATE
RFI RESPONSES	05-04-22
DRWN: RMS	CHK'D: SJS
APPR'D: SJS	

DATE: 04-13-2022	PROJECT NUMBER	SHEET NUMBER	SHEET
	30186		E2.1

#### DRAWING NOTES:

- "NL" DENOTES NIGHTLIGHT ON 24/7 AND CONNECTED TO EXISTING EMERGENCY POWER PANEL WITH GENERATOR BACK-UP.
- PROVIDE LIGHT CONTROLS WITH DIMMING AND SCENE CONTROLLER. LIGHTING TO OPERATE 'ON' UPON OCCUPANCY SINCE THESE LIGHTS ARE LOCATED IN THE PATH OF EGRESS.
- ALL TYPE "AN" LIGHTING FIXTURES ARE LIGHT ENABLED. CONTRACTOR SHALL INTERCONNECT FIXTURES WITH PLENUM RATED CATEGORY 5 CABLE.

#### GENERAL NOTES:

THE MINIMUM WIRE SIZE SHALL BE #12 AWG. PROVIDE DEDICATED NEUTRALS; NO COMMON NEUTRALS ARE PERMITTED.

THE MINIMUM CONDUIT SIZE FOR HOMERUNS AND BRANCH FEEDS SHALL BE 3/4" 1/2" CONDUIT SHALL BE ACCEPTABLE FOR BRANCH WIRING FOR SINGLE CIRCUITS ONLY. ALL BRANCH CIRCUITS SHALL TERMINATE AT 20A-1P CIRCUIT BREAKERS IN PANELBOARD INDICATED UNLESS SPECIFICALLY INDICATED OTHERWISE.

THE CONTRACTOR SHALL UPSIZE CONDUCTORS AND CONDUITS (OVER 75'-0" IN LENGTH) TO COMPENSATE FOR VOLTAGE DROP.

THE CONTRACTOR SHALL PROVIDE ALL PENETRATIONS, SLEEVES AND SEALANT AS REQUIRED THRU PARTITIONS TO ACCOMMODATE ANY CONDUITS / RACEWAYS, CABLING, ETC. ALL PENETRATIONS THRU RATED WALL ASSEMBLY(IES) MUST MEET THE UL RATING OF THE WALL SYSTEM(S).

REFER TO ARCHITECTURAL PLANS FOR ADDITIONAL INFORMATION REGARDING MOUNTING HEIGHTS AND EXACT LOCATIONS OF ALL ELECTRICAL DEVICES BEFORE ROUGH-IN.

THE CONTRACTOR SHALL VERIFY EXACT EQUIPMENT LOCATIONS, LOAD INFORMATION, VOLTAGE, AMPERAGE, CONNECTION TYPE, ETC. WITH EQUIPMENT BEING SUPPLIED PRIOR TO ROUGH-IN.

ALL CIRCUITING NUMBERS ARE CONNECTED TO PANEL "LP-BN" UNLESS SPECIFICALLY INDICATED OTHERWISE.

#### DEVICE SYMBOLS LEGEND:

SYMBOL DESCRIPTION

- X EXISTING ELECTRICAL EQUIPMENT OR DEVICE TO REMAIN.
- XRR EXISTING ELECTRICAL EQUIPMENT OR OUTLET TO BE REMOVED, RELOCATED AND JUNCTION BOX REMOVED AND WALL PATCHED.
- XR EXISTING ELECTRICAL EQUIPMENT OR OUTLET RELOCATED (NEW LOCATION).
- XO NEW ELECTRICAL EQUIPMENT INSTALLED OVER EXISTING OUTLET.

ALL UNMARKED LIGHTING FIXTURES ARE TYPE "AN" UNLESS INDICATED OTHERWISE - TYPICAL.

HOMERUN ALL NORMAL LIGHTING BRANCH CIRCUITS TO EXISTING PANEL "LP-BN" AND EMERGENCY LIGHTING CIRCUITS TO EXISTING PANEL "EM1-S1" (ON FIRST FLOOR). CIRCUIT NUMBERS INDICATED ARE FOR REFERENCE PURPOSES ONLY IN ORDER TO INDICATE GROUPING.




BASE BID: NO WORK IN THIS AREA  
ALTERNATE BID: PROVIDE WORK AS INDICATED.

#### BASEMENT - LIGHTING PLAN

SCALE:

1/8" = 1'-0"

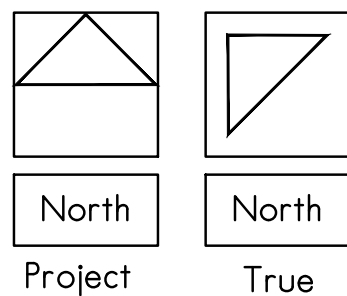

#### LIGHTING CONTROLS SCHEDULE:

AREA SERVED	VACANCY SENSOR	OCCUPANCY SENSOR	TIME-CLOCK	DIMMING	DAYLIGHTING	SCENES	REMARKS
OFFICES AND CONFERENCE ROOMS	✓			✓			
TOILETS, JANITOR, AND STORAGE ROOMS		✓					
LOBBY, ATTAINMENT LAB AND PAES LAB		✓		✓		✓	PROVIDE WITH TWO SCENES PER AREA AND PROGRAMMED PER OWNER REQUIREMENTS.



# DRAWING NOTES:

- ① EXISTING PANELBOARD TO REMAIN. CONTRACTOR SHALL TRACE OUT ALL EXISTING LOADS SERVED FROM THIS PANEL. ALL CIRCUITS WHICH NEED TO REMAIN ACTIVE AFTER DEMOLITION TO REMAIN. CONTRACTOR SHALL PROVIDE ADDITIONAL CONDUIT AND WIRING REQUIRED TO MAINTAIN ACTIVE. ALL CIRCUITS MADE SPARE DURING DEMOLITION SHALL BE MARKED ACCORDINGLY FOR RE-USE.
- ② CONTRACTOR SHALL ELECTRICALLY DISCONNECT EXISTING KITCHEN EQUIPMENT FOR REMOVAL. ONCE KITCHEN EQUIPMENT HAS BEEN REMOVED, CONTRACTOR SHALL REMOVE ALL RECEPTACLES, DISCONNECTS, STARTERS, DEVICES, CONDUIT, WIRING, AND CABBING.
- ③ REINSTALL INTO NEW CEILING.

GENERAL DEMOLITION NOTES:

1. ALL RELATED ELECTRICAL EQUIPMENT, FIXTURES, DEVICES AND INDICATED CONDUIT AND WIRING TO BE REMOVED UNLESS NOTED OTHERWISE. RE-FEED ANY DOWNSTREAM ITEMS WHICH REMAIN.
2. THE REMOVAL OF THE ELECTRICAL SYSTEM AS NOTED FOR ON THE DEMOLITION DRAWINGS SHALL BE COORDINATED WITH THE RENOVATION REQUIREMENTS TO DETERMINE THIS CONTRACTORS WORK.
3. IT IS THE INTENT OF THE ELECTRICAL DEMOLITION DRAWING(S) TO INDICATE AREAS IN WHICH ELECTRICAL EQUIPMENT, CONDUIT, LIGHTING FIXTURES, DEVICES, ETC., NEED TO BE REMOVED. LOCATED OR FIELD BY THIS CONTRACTOR TO ALLOW FOR THE RENOVATION PHASE OF CONSTRUCTION. THE ELECTRICAL DEMOLITION PLAN IS FOR REFERENCE PURPOSES ONLY AND IT IS NOT INTENDED TO BE THE SOLE SOURCE OF EXISTING CONDITIONS.
4. THIS CONTRACTOR SHALL VISIT THE BUILDING, BEFORE SUBMITTING HIS BID, TO VERIFY THE EXISTING CONDITIONS WHICH WILL AFFECT HIS WORK.
5. THIS CONTRACTOR SHALL BE RESPONSIBLE FOR THE COMPLETE ELECTRICAL DEMOLITION REQUIRED TO ACCOMMODATE THE RENOVATION. REMOVE AS REQUIRED ALL LIGHTING FIXTURES, RECEPTACLES, EQUIPMENT, DEVICES, ETC., PER OUT ALL USED AND CONDUITS AND CABLES AND REMOVE ALL ABANDONED CONDUIT. ALL REMOVED EQUIPMENT SHALL BECOME THE PROPERTY OF THE CONTRACTOR AND SHALL BE REMOVED FROM THE SITE UNLESS NOTED OTHERWISE.
6. THE CONTRACTOR SHALL IDENTIFY ALL CONDUITS ENTERING PANELBOARDS WITHIN AREA OF WORK. ALL ABANDONED CONDUITS TO BE TAGGED "PIPE ABANDONED" IF THE PIPE IS NO LONGER ACCESSIBLE IN THE FIELD, I.E.: CUT OFF AND ABANDONED IN THE FLOOR OR WALL.

DEMOLITION SYMBOLS:

SYMBOL	DESCRIPTION
X	EXISTING ELECTRICAL EQUIPMENT OR OUTLET TO REMAIN.
R	EXISTING ELECTRICAL EQUIPMENT OR OUTLET TO BE REMOVED
XRR	EXISTING ELECTRICAL EQUIPMENT OR OUTLET TO BE REMOVED RELOCATED AND JUNCTION BOX REMOVED OR CAPPED AS REQUIRED.
XR	EXISTING ELECTRICAL EQUIPMENT OR OUTLET RELOCATED (NEW LOCATION).


**SALVAGED EQUIPMENT NOTE:**

THE FOLLOWING EQUIPMENT TO BE REMOVED BY OWNER / OWNER'S CONTRACTOR. DO NOT THROW OUT ANY:

- WALL MOUNTED DISPLAY
- AUDIO-VISUAL PROJECTOR
- MOTORIZED PROJECTION SCREENS
- WIRELESS ACCESS POINT
- LOCAL SOUND SYSTEM EQUIPMENT
- A/V EQUIPMENT SHELF
- DOOR SECURITY EQUIPMENT
- ACCESS CONTROL DEVICES
- KITCHEN EQUIPMENT

EXISTING CONDITIONS NOTE:

1. EXISTING CONDITIONS WERE DEVELOPED BY A COMBINATION OF FIELD SURVEYING, AS-BUILTS, SERVICING CONTRACTOR'S PROGRAM REPORT, ETC... BUT SOME ASSUMPTIONS WERE MADE DUE TO LIMITED ACCESS (I.E. CASEWORK / EQUIPMENT OBSTRUCTIONS, "HIDDEN" FROM VIEW IN HIGH / DARK CEILINGS, ETC.... THESE PLANS SHALL NOT BE THE SOLE SOURCE OF EXISTING CONDITIONS, CONTRACTOR SHALL FIELD VERIFY ALL AS REQUIRED AND IMMEDIATELY NOTIFY ARCHITECT / ENGINEER OF ANY DEVIATIONS AND / OR PROBLEMATIC ITEMS.

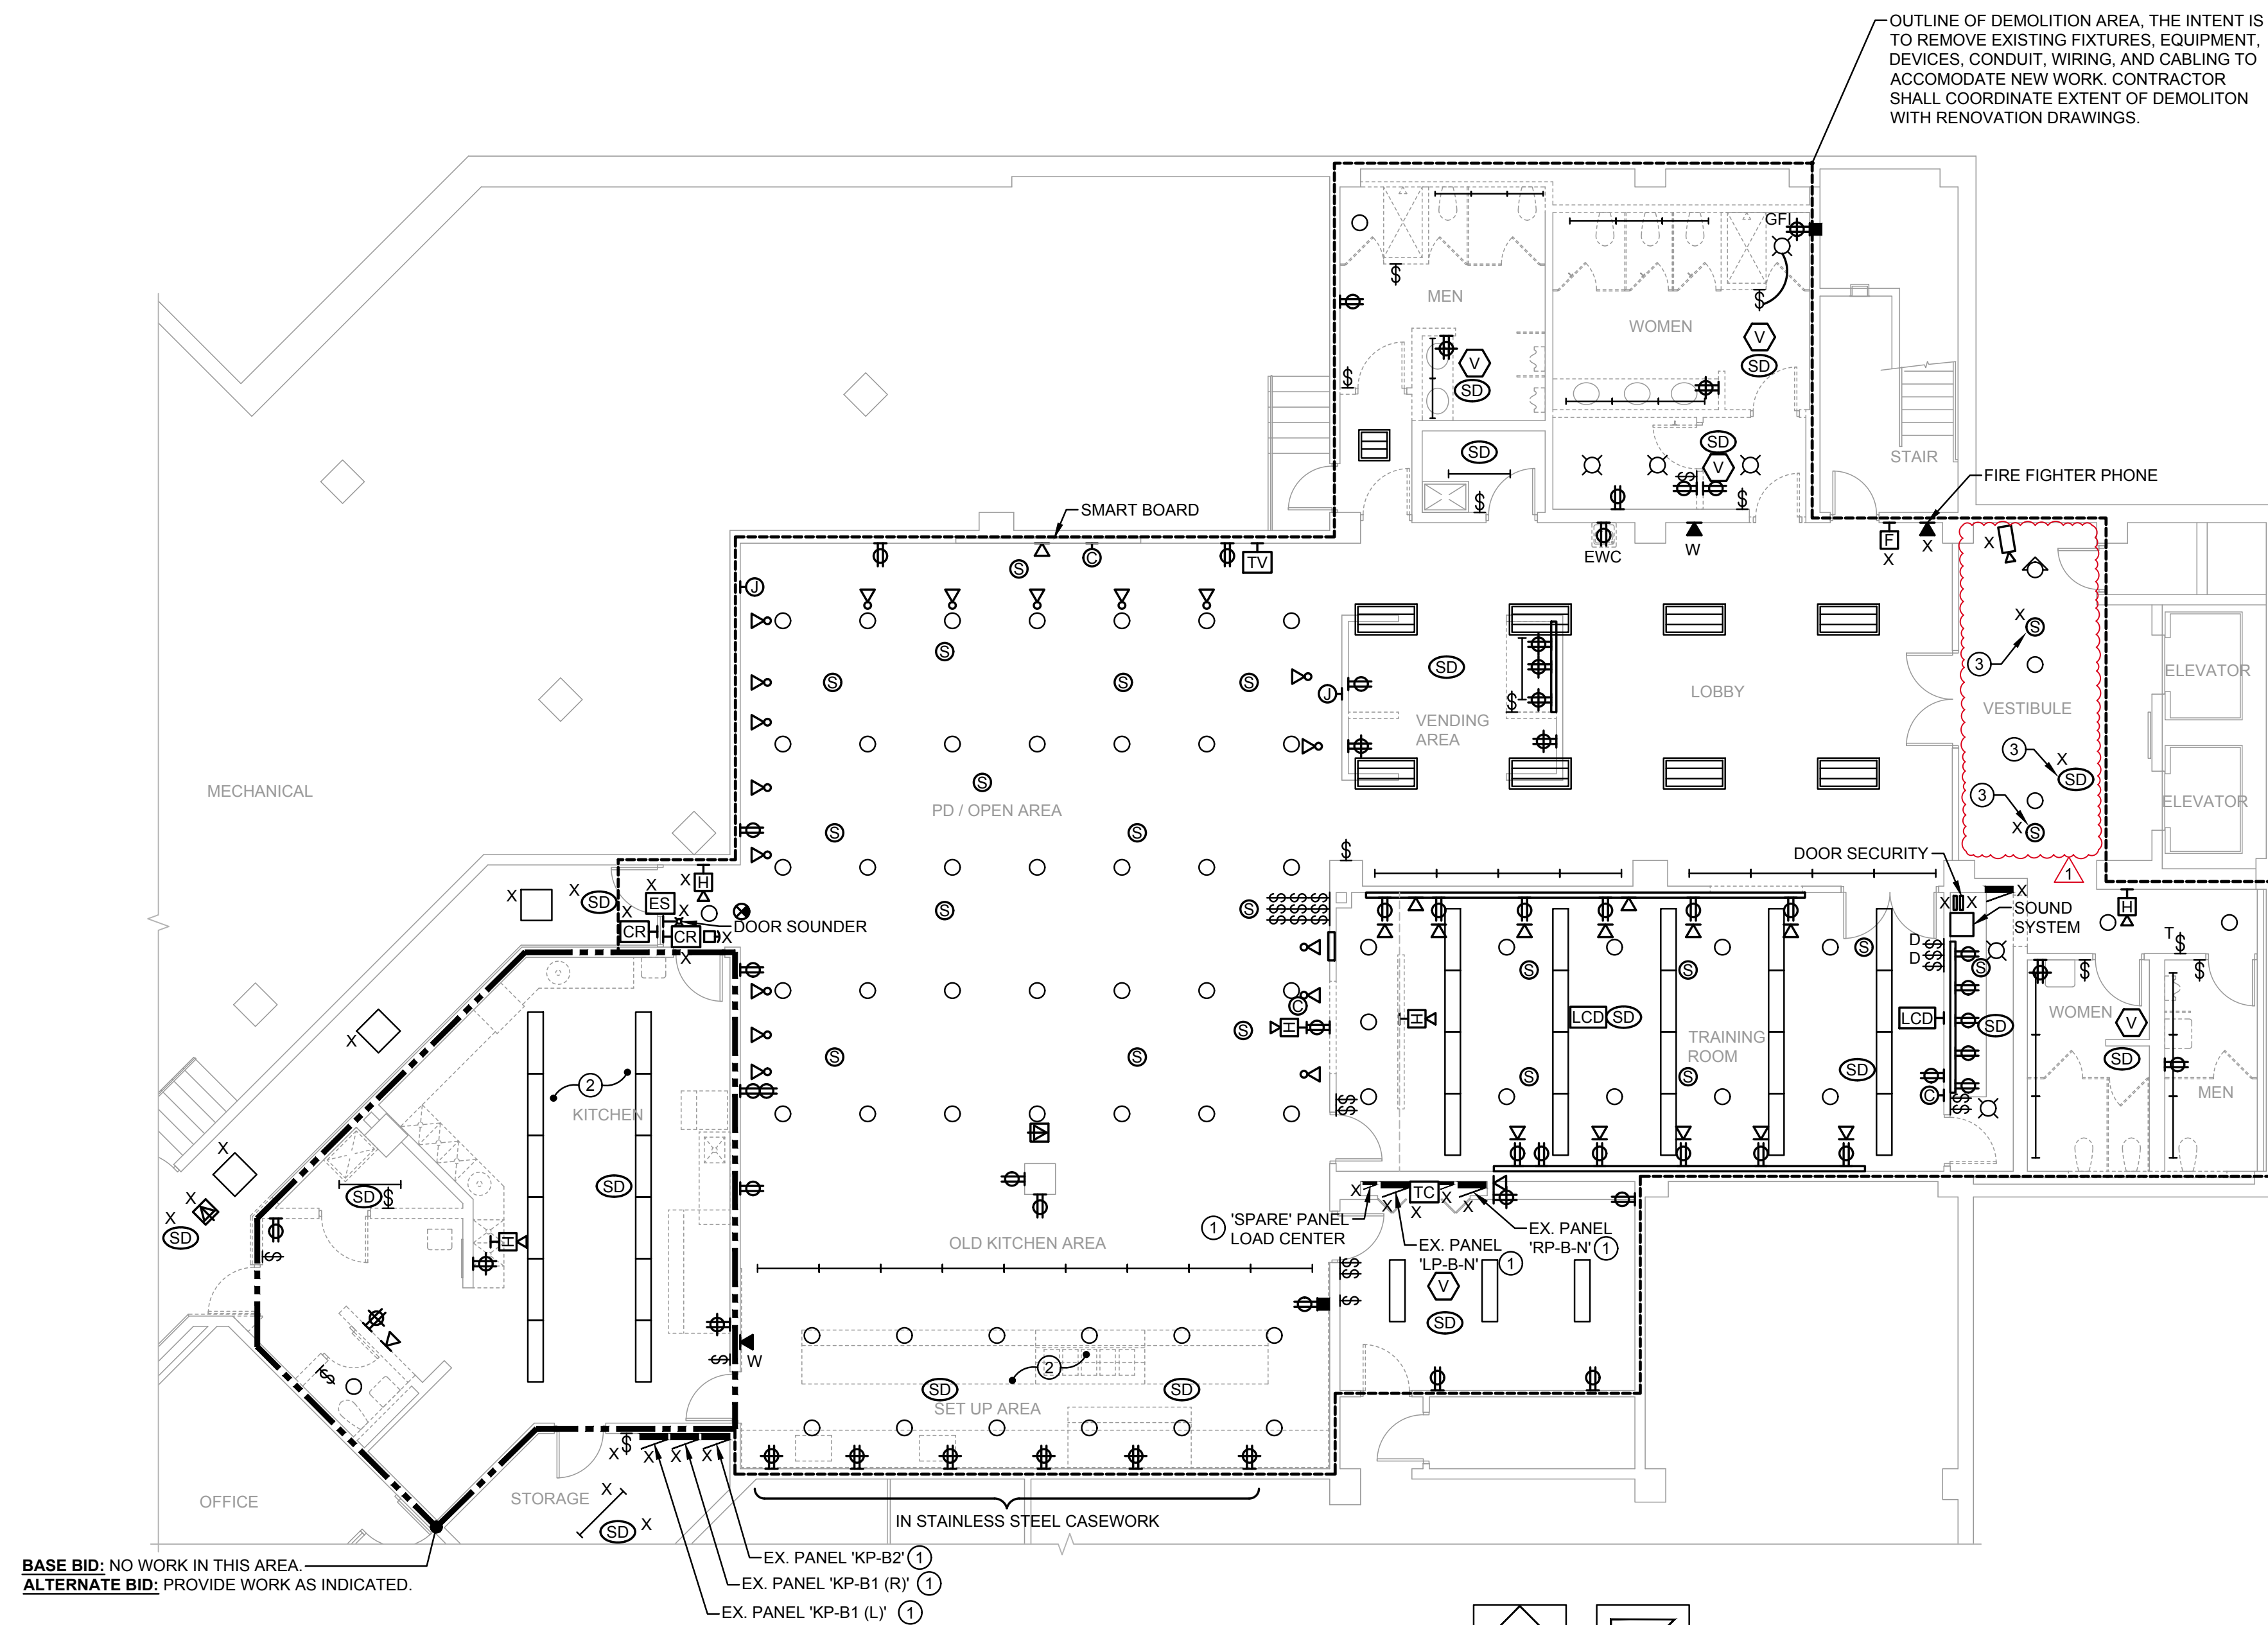

# BASEMENT DEMOLITION – ELECTRICAL PLAN

SCALE:

$$1/8" = 1'-0"$$
