

# ROCKFORD BOARD OF EDUCATION INVITATION FOR BID ON SUPPLIES, MATERIALS, EQUIPMENT OR SERVICES FOR SCHOOL DISTRICT NO. 205 ROCKFORD, ILLINOIS

IFB No. 23-27 Asbestos Abatement at Washington, Flinn & East Schools

DATE: September 23, 2022

RE: **ADDENDUM NO. 1** 

#### To All Bidders:

Included are modifications, clarifications and/or corrections for the Project Manual and are hereby made a part of the contract documents. Please attach this addendum to the Project Manual(s) in your possession. Please note the receipt of this addendum on the bid form. Bidders shall review changes to all portions of this work as changes to one portion may affect the work of another.

If you plan to hand deliver your IFB submission on the due date, please note you must check in on the 1st floor prior to coming to the bid opening. Please allow time for this as late submission will not be accepted.

Refer all questions relative to the business aspect, Instructions to Bidders, Special Conditions, and questions concerning the technical aspect of the documents to the Director of Purchasing by email at <a href="mailto:purchasingdeptstaff@rps205.com">purchasingdeptstaff@rps205.com</a>.

#### ROCKFORD BOARD OF EDUCATION

By: Dane Youngblood Director of Purchasing

600 West Van Buren St., Suite 500, Chicago, IL 60607 t: 312.782.4486 f: 312.782.5145



DATE: September 23, 2022

TO:

Guy Carynski <u>guy.carynski@rps205.com</u>
Dane Youngblood <u>dane.youngblood@rps205.com</u>

Casey Ramas <u>ramasc@rps205.com</u>

Paul Middleton <u>paul@abelplusservices.com</u>
Tomasz Stogowski <u>tomasz.husar1@gmail.com</u>
Kevin Murray kmurray@ehcindustries.com

Revin Murray
Robert Boll
Steve Zuchaik
John Gorniak
Ryan Feil
Kevin McKinney

Rmurray@encindustries.com
bboll@colfaxcorp.net
szuchaik@luse.com
dem@demservices.com
rfeil@nesincorp.com
kmckinney@ifspm.com

Todd Jabaay <u>tjabaay@ifspm.com</u>
Joe Rodriguez <u>joer@kinsalecg.com</u>

# SUBJECT: ADDENDUM NO. 1 TO THE BIDDING DOCUMENTS IFB NO. 23-27 ASBESTOS ABATEMENT AT EAST, FLINN, AND WASHINGTON SCHOOLS

This addendum forms a part to the bidding and contract documents and modifies the original bidding documents, dated August 18, 2022. ALL CONTRACTORS SHALL ACKNOWLEDGE WRITTEN RECEIPT OF THIS ADDENDUM ON THEIR BID FORM. FAILURE TO DO SO MAY SUBJECT BIDDER TO DISQUALIFICATION.

#### East School

- 1. ASB-G: Scope of work, schedule, and bid allowances modified.
- 2. ASB-1: Scope of work modified.
- 3. New Bid Form

# Flinn School

- 1. ASB-G: Scope of work and bid allowance modified.
- 2. ASB-1: Additional mini-containment in storage room. Removal of scope of work in tunnels and associated decontamination units/barriers. Additional scope added regarding the demolition of soffit in faculty lounge.
- 3. New Bid Form.

#### Washington School

- 1. ASB-G: Change to schedule and bid allowance.
- 2. ASB-1: Title block modified.
- 3. ASB-2: Scope of work reduced.
- 4. ASB-3: Title block modified.

- 5. ASB-4: Title block modified.
- 6. ASB-5: Title block modified.
- 7. ASB-6: Title block modified.
- 8. New Bid Form

Except as modified herein, Addendum No. 1, Project Manual dated August 18, 2022 remain in full force and effect.

CARNOW, CONIBEAR & ASSOC., LTD.

**Evan Christian** 

Senior Department Manager



# Rockford Public Schools 205 IFB 23-27 Asbestos Abatement at East Middle School ESSER HVAC Improvements

# EAST MIDDLE SCHOOL ASBESTOS ABATEMENT BID FORM

PROJE	CT: IFB 23-27 Asbestos Abatement at East Middle School				
SCHOO	L DISTRICT: Rockford Public Schools – District #205				
ENVIRO	NMENTAL CONSULTANT: Carnow, Conibear & Assoc., Ltd.				
TO:	Rockford Board of Education School District No. 205 Rockford, Illinois				
FROM:	(Bidder)				
	Having carefully examined the Contract Documents dated August 18, 2022 Rockford Public Schools – District #205, receipt of which is hereby acknowledge.				
	Addendum No.:       Dated.:       ;         Addendum No.:       Dated.:       ;         Addendum No.:       Dated.:       ;         Addendum No.:       Dated.:       ;				
	and having inspected the Site of the Work and become familiar with the corwith the requirements of the Contract, the undersigned hereby proposes to notifications, accessories, transportation and other work necessary to performance, complete in a workman like manner the Work, as required by Contract Documents and Environmental Project Manual dated August 18, 2	furnish all labor, tools, materials, prm and, within the specified Time and in strict accordance with the	permits,		
NOTE: I	BIDDER MUST FILL IN NUMERICAL FIGURE FOR ALL ITEM #s BELOW C	OR BID SHALL BE DISQUALIFIED	D.		
Asbes	stos Abatement	Cost:			
Base	Bid Work - Asbestos Abatement	\$			
	nate #1 Bid Allowance A - Abatement of Pipe Insulation as ed on ASB-G.	\$			
	nate #2 Bid Allowance B - Abatement of Floor Tile and Mastic tailed on ASB-G.	\$			
	Bid (Base Bid + Alternate #1 Bid Allowance A + Alternate #2	\$			

# UNIT PRICE SCHEDULE FOR BID ALLOWANCE

Add/Deduct price per linear fo containment (500 linear foot l	oot for the removal of pipe insulation within an existing ncluded in Base Bid).
\$	<del></del>
Add/Deduct price per 2'x2' are square feet Included in Base	ea for the non-friable removal of floor tile and mastic (200 Bid).
\$	
Add/Deduct price for a negati airlock per IDPH regulation 85	ive pressure, tented glovebag enclosure with attached 55.480.
\$	
UNIT PRICE SCHEDULE FOR	
Price for a fully loaded daily r	rate for licensed Supervisor (include mobilizations costs)
\$	
ACKNOWLEDGEMENTS:	
	the Bidder has carefully examined the Contract Documents, Addenda (if any) of proposed work; has become familiar with the conditions affecting the
	y conditions or qualifying statements to this Bid, as such additions may cause al and as not being responsive to the Invitation for Bids.
opening, the Bidder will be lia Undersigned to enter into a C	dersigned agrees that, if this Bid is accepted within sixty (60) days after bid ble to the Owner for damages the Owner may suffer by failure of the contract and deliver the necessary bonds together with required insurance's seven days after notice of Contract award.
Bidding Company Name:	
Authorized Signature:	
Title:	
Date:	
Corporate Seal	

# Rockford Public Schools 205 IFB 23-27 Asbestos Abatement at Flinn Middle School ESSER HVAC Improvements

# FLINN MIDDLE SCHOOL ASBESTOS ABATEMENT BID FORM

PROJE	CT: IFB 23-27 Asbestos Abatement at Flinn Middle School		
SCHOO	DL DISTRICT: Rockford Public Schools – District #205		
ENVIRO	DNMENTAL CONSULTANT: <u>Carnow, Conibear &amp; Assoc., Ltd.</u>		
TO:	Rockford Board of Education School District No. 205 Rockford, Illinois		
FROM:	(Bidder)		
	Having carefully examined the Contract Documents dated August 18 Rockford Public Schools – District #205, receipt of which is hereby ac		
	Addendum No.:       Dated.:         Addendum No.:       Dated.:         Addendum No.:       Dated.:         Addendum No.:       Dated.:	; :	
	and having inspected the Site of the Work and become familiar with twith the requirements of the Contract, the undersigned hereby proponotifications, accessories, transportation and other work necessary to Performance, complete in a workman like manner the Work, as required Contract Documents and Environmental Project Manual dated August	ses to furnish all labor, tools, materials, perform and, within the specified Time red by and in strict accordance with the	permits, e for
NOTE:	BIDDER MUST FILL IN NUMERICAL FIGURE FOR ALL ITEM #s BEI	OW OR BID SHALL BE DISQUALIFIE	D.
Asbe	stos Abatement	Cost:	]
<u>Base</u>	Bid Work - Asbestos Abatement	\$	
	nate #1 Bid Allowance - Abatement of Pipe Insulation from a led on ASB-G.	as \$	
<u>Total</u>	Bid (Base Bid + Bid Allowance)	\$	
			_

# **UNIT PRICE SCHEDULE FOR BID ALLOWANCE**

	educt price per linear foot for the removal of pipe insulation within an existing ment (500 Linear Foot Included in Base Bid).
\$	
	educt price for a negative pressure, tented glovebag enclosure with attached per IDPH regulation 855.480.
\$	
UNIT P	RICE SCHEDULE FOR CONTINGENCY
Price fo	or a fully loaded daily rate for licensed Supervisor (include mobilizations costs)
\$	
Ψ	<del></del>
ACKNOV	VLEDGEMENTS:
	The undersigned agrees that the Bidder has carefully examined the Contract Documents, Addenda (if any) and has inspected each site of proposed work; has become familiar with the conditions affecting the Contract.
	The Bidder has not added any conditions or qualifying statements to this Bid, as such additions may cause the Bid to be declared informal and as not being responsive to the Invitation for Bids.
	By submitting this Bid the Undersigned agrees that, if this Bid is accepted within sixty (60) days after bid opening, the Bidder will be liable to the Owner for damages the Owner may suffer by failure of the Undersigned to enter into a Contract and deliver the necessary bonds together with required insurance's and other documents within seven days after notice of Contract award.
	Bidding Company Name:
	Authorized Signature:
	Title:
	Date:
	Corporate Seal

# Rockford Public Schools 205 IFB 23-27 Asbestos Abatement at Washington Middle School ESSER HVAC Improvements

# WASHINGTON MIDDLE SCHOOL ASBESTOS ABATEMENT BID FORM

PROJECT: IFB 23-27 Asbestos Abatement at Washington Middle School	
SCHOOL DISTRICT: Rockford Public Schools – District #205	
ENVIRONMENTAL CONSULTANT: Carnow, Conibear & Assoc., Ltd.	
TO: Rockford Board of Education School District No. 205 Rockford, Illinois	
FROM:(Bidder)	
Having carefully examined the Contract Documents dated August 18, 2022 Rockford Public Schools – District #205, receipt of which is hereby acknowledge.	
Addendum No.:       Dated.:       ;         Addendum No.:       Dated.:       ;         Addendum No.:       Dated.:       ;         Addendum No.:       Dated.:       ;	
and having inspected the Site of the Work and become familiar with the conwith the requirements of the Contract, the undersigned hereby proposes to notifications, accessories, transportation and other work necessary to perfor Performance, complete in a workman like manner the Work, as required by Contract Documents and Environmental Project Manual dated August 18, 2	furnish all labor, tools, materials, permits, rm and, within the specified Time for and in strict accordance with the
NOTE: BIDDER MUST FILL IN NUMERICAL FIGURE FOR ALL ITEM #s BELOW O	OR BID SHALL BE DISQUALIFIED.
Asbestos Abatement	Cost:
Base Bid Work - Asbestos Abatement	\$
Alternate #1 Bid Allowance - Abatement of Pipe Insulation as detailed on ASB-G.	\$
Total Bid (Base Bid + Bid Allowance Alternate #1)	\$

# **UNIT PRICE SCHEDULE FOR BID ALLOWANCE**

Add/Deduct price per linear foot for the removal of pipe insulation within an existing containment (500 Linear Foot Included in Base Bid).
\$
Add/Deduct price for a negative pressure, tented glovebag enclosure with attached airlock per IDPH regulation 855.480.
\$
UNIT PRICE SCHEDULE FOR CONTINGENCY
Price for a fully loaded daily rate for licensed Supervisor (include mobilizations costs)
\$
ACKNOW! EDGEMENTS:
ACKNOWLEDGEMENTS:  The undersigned agrees that the Bidder has carefully examined the Contract Documents, Addenda (if any and has inspected each site of proposed work; has become familiar with the conditions affecting the Contract.
The Bidder has not added any conditions or qualifying statements to this Bid, as such additions may caus the Bid to be declared informal and as not being responsive to the Invitation for Bids.
By submitting this Bid the Undersigned agrees that, if this Bid is accepted within sixty (60) days after bid opening, the Bidder will be liable to the Owner for damages the Owner may suffer by failure of the Undersigned to enter into a Contract and deliver the necessary bonds together with required insurance's and other documents within seven days after notice of Contract award.
Bidding Company Name:
Authorized Signature:
Title:
Date:
Corporate Seal

#### **ASBESTOS ABATEMENT**

#### SCOPE OF WORK

- 1. Abatement of duct insulation and demolition of duct from basement mechanical space.
- 2. Work to be conducted per specification section 02131 and applicable IDPH, IEPA, and OSHA rules and regulations.

# BID ALLOWANCE (ALTERNATE #1):

A. Removal and disposal of pipe insulation using glovebag removal methods within mini-enclosures as needed by General Contractor. The General Contractor shall be responsible for all demolition necessary to access the insulation. The bid allowance shall be a not-to-exceed cost and include the abatement of up to 250 linear feet of thermal system insulation from up to 10 mini-enclosures. Cost adjustments for addition or deductions will be made based on actual quantities and per price schedule. Price shall include one (1) mobilization.

# **BID ALLOWANCE (ALTERNATE #2)**

B. Removal and disposal of floor tile and mastic with non-friable removal methods. The bid allowance shall be a not-to-exceed cost and include abatement of up to 200 square feet of floor tile and mastic in up to fifty (50) 2'x2' areas to accommodate new piping. Cost adjustments for addition or deductions will be made based on actual quantities and per price schedule. price shall include one (1) mobilization.

# **GENERAL NOTES**

- 1. Locations shown are approximate only.
- 2. Phasing of the work to be determined by the General Contractor and the Building Owner.
- 3. Worker decontamination enclosure system shall be constructed in strict accordance with IDPH section 855.410. Clean room shall be sized to accommodate the needs of the work crew. Donning and doffing of PPE outside of clean room is strictly prohibited.
- 4. Where non-friable removal methods are utilized (Specification Section 3.11(D)), Contractor shall be responsible for the isolation of the work area(s) with critical seals, signage, and the security of the work areas to eliminate access by unauthorized personnel.
- 5. HEPA filtered negative air machines shall be set up within the work areas and run continuously through the completion of all work.
- 6. The abatement contractor is responsible for the lockout and tagout of all mechanical equipment prior to starting any mitigation/ abatement or O&M clean up in or on any equipment, etc.
- 7. The contractor is responsible for verifying quantities in the field before bidding. Any questions about the scope or clarifications shall be obtained from the Project Designer prior to bidding. Any interpretations of the design documents shall only be made by the Project Designer. The abatement contractor shall be responsible for removing any ACM which will be disturbed during renovation activities, prior to renovation activities.
- 8. When a room or location identified on an environmental scope of work sheet, all closets, bathrooms, offices, storage rooms, etc. are included in the scope of work for that room or location.

- 9. The abatement contractor is responsible for all security to the work area(s) during the environmental mitigation/abatement and replacement activities. The abatement contractor shall be responsible for any damages or thefts to property in the work area(s), until the area(s) are returned to the property owner. The abatement contractor shall repair and/or replace damaged or stolen property to the satisfaction of, and at no additional cost to the property owner.
- 10. Electric/HVAC service shall be disconnected by the District as necessary.
- 11. Any existing electrical panels in the work area shall be adequately protected (i.e. "Boxed out.") during Asbestos Abatement activities in accordance with specification 02131 and all applicable regulations.
- 12. Contractor shall maintain clear access to building egress points outside of regulated areas.
- 13. The School District will provide an electrician for the installation of temporary power panels and/or whips and isolation of work areas. The Abatement Contractor is responsible for providing District electrician any power panels and/or whips a minimum of five (5) business days prior to start of work. Coordinate with Carnow Conibear.
- 14. If abatement of flooring materials is specified, the Abatement Contractor is responsible for the removal of all layers of flooring, associated mastics, and leveling compounds down to the lowest substrate. Unless specified, NO CHEMICAL REMOVAL OF MASTICS shall be utilized. Mechanical removal methods ONLY.
- 5. Contractor Supervisor is required to perform a punch list walk-through with a Carnow Conibear representative prior to containment tear-down AND demobilization to ensure all scope items have been removed, project specifications are met, and any incidental damage is identified.
- 16. Contractor shall remove dumpster from site within two (2) weeks of project completion. District may seek damages of \$500/day for dumpsters not removed.

# SCHEDULE:

Anticipated base bid start date is June 9, 2023 (last day of school) and shall be completed by June 21, 2023. If feasible, base bid work may begin in May 2023. Alternate scope of work will be conducted summer 2023.

	emess, starage rearrie, star are mara					
DRAWING HISTORY						
NO.	DATE	DRAWN BY:	CHECKED BY:	REMARKS		
1	01/07/2020	D. Pfolsgrof	E. Christian	ISSUED FOR BID		

Rockford Public School District #205 501 7th Street Rockford, Illinois 61104 Asbestos Abatement East High School 2929 Charles St. Rockford, Illinois 61108


Rod Harvey

PROJECT DESIGNER

GENERAL NOTES ADDENDUM NO. 1 Carnow, Conibear & Assoc., Ltd. Environmental Consulting Services 600 W. Van Buren St., Suite 500, Chicago, IL 60607 t: 312.782.4486 f: 312.782.5145 www.ccalltd.com OT DATE: SEPTEMBER 23, 2022


**ASB-G** 

CARNOW

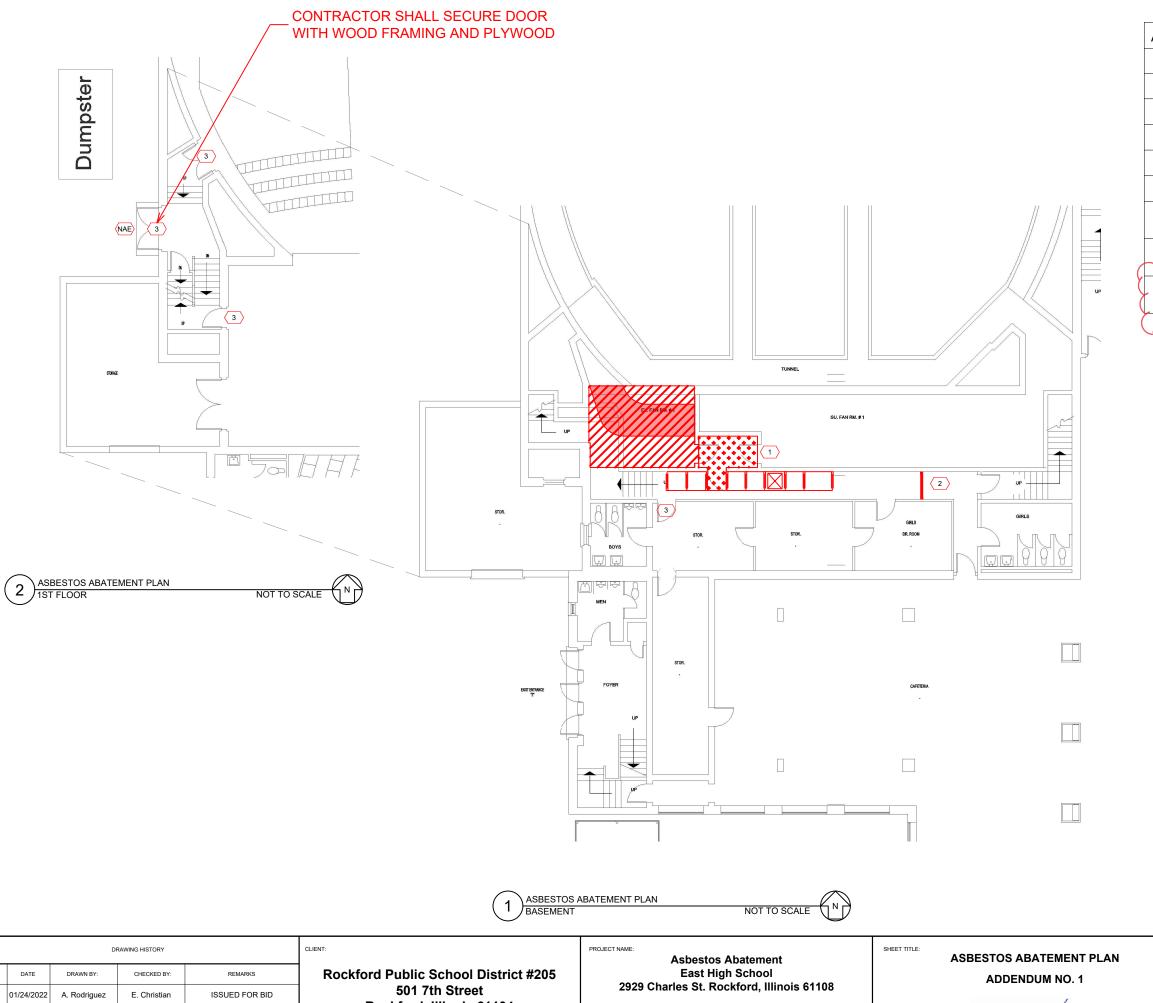

ASBESTOS ABATEMENT KEYNOTES Worker decontamination unit. Waste decontamination unit. NAE Negative Air Exhaust 1 Separation barrier per IDPH 855.430(a) 2 Separation barrier per IDPH 855.430(b) (with lockable door) 3 Contractor to secure door and control access Asbestos Abatement Work Area Containment Tunnel - No Removal Abatement of ACM Duct Insulation and Demolition of Duct

# **KEY PLAN:**

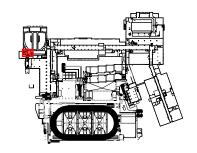

DRAWING HISTORY					
NO.	DATE	DRAWN BY:	CHECKED BY:	REMARKS	
1	01/24/2022	A. Rodriguez	E. Christian	ISSUED FOR BID	

Rockford, Illinois 61104

Rod Harvey IDPH #: 100-01548 DESIGNER SIGNATURE

PROJECT DESIGNER

Carnow, Conibear & Assoc., Ltd. Environmental Consulting Services 600 W. Van Buren St., Suite 500, Chicago, IL 60607 t: 312.782.4486 f: 312.782.5145 www.ccaltd.com CCA PROJECT NO.

SEPTEMBER 23, 2022

ASB-1 CARNOW CONIBEAR

# SCOPE OF WORK

# **ASBESTOS ABATEMENT:**

- 1. Abatement of thermal systems pipe insulation with gross removal and mini-enclosure glovebag methods.
- 2. Work to be conducted per specification section 02131 and applicable IDPH, IEPA, and OSHA rules

  and regulations.

  BID ALLOWANCE (ALTERNATE #1):

Removal and disposal of pipe insulation using glovebag removal methods within mini-enclosures as needed by General Contractor. (The General Contractor shall be responsible for all demolition necessary to access the insulation. The bid allowance shall be a not-to-exceed cost and include the abatement of up to 250 linear feet of thermal system insulation from up to 10 mini-enclosures. Cost adjustments for addition or deductions will be made based on actual quantities and per price schedule. Price shall include one (1) mobilization.

# **GENERAL NOTES**

- 1. Locations shown are approximate only.
- 2. Phasing of the work to be determined by the General Contractor and the Building Owner.
- 3. Worker decontamination enclosure system shall be constructed in strict accordance with IDPH section 855.410. Clean room shall be sized to accommodate the needs of the work crew. Donning and doffing of PPE outside of clean room is strictly prohibited.
- 4. Where non-friable removal methods are utilized (Specification Section 3.11(D)), Contractor shall be responsible for the isolation of the work area(s) with critical seals, signage, and the security of the work areas to eliminate access by unauthorized personnel.
- 5. HEPA filtered negative air machines shall be set up within the work areas and run continuously through the completion of all work.
- 6. The abatement contractor is responsible for the lockout and tagout of all mechanical equipment prior to starting any mitigation/ abatement or O&M clean up in or on any equipment, etc.
- 7. The contractor is responsible for verifying quantities in the field before bidding. Any questions about the scope or clarifications shall be obtained from the Project Designer prior to bidding. Any interpretations of the design documents shall only be made by the Project Designer. The abatement contractor shall be responsible for removing any ACM which will be disturbed during renovation activities, prior to renovation activities.
- 8. When a room or location identified on an environmental scope of work sheet, all closets, bathrooms, offices, storage rooms, etc. are included in the scope of work for that room or location.

- 9. The abatement contractor is responsible for all security to the work area(s) during the environmental mitigation/abatement and replacement activities. The abatement contractor shall be responsible for any damages or thefts to property in the work area(s), until the area(s) are returned to the property owner. The abatement contractor shall repair and/or replace damaged or stolen property to the satisfaction of, and at no additional cost to the property owner.
- 10. Electric/HVAC service shall be disconnected by the District as necessary.
- Any existing electrical panels in the work area shall be adequately protected (i.e. "Boxed out.")
  during Asbestos Abatement activities in accordance with specification 02131 and all applicable
  regulations.
- 12. Contractor shall maintain clear access to building egress points outside of regulated areas.
- 3. The School District will provide an electrician for the installation of temporary power panels and/or whips and isolation of work areas. The Abatement Contractor is responsible for providing District electrician any power panels and/or whips a minimum of five (5) business days prior to start of work. Coordinate with Carnow Conibear.
- 14. If abatement of flooring materials is specified, the Abatement Contractor is responsible for the removal of all layers of flooring, associated mastics, and leveling compounds down to the lowest substrate. Unless specified, NO CHEMICAL REMOVAL OF MASTICS shall be utilized. Mechanical removal methods ONLY.
- 15. Contractor Supervisor is required to perform a punch list walk-through with a Carnow Conibear representative prior to containment tear-down AND demobilization to ensure all scope items have been removed, project specifications are met, and any incidental damage is identified.
- 16. Contractor shall remove dumpster from site within two (2) weeks of project completion. District may seek damages of \$500/day for dumpsters not removed.

# SCHEDULE:

#### Winter Break 2022:

Scope of work outlined in ASB-3 and ASB-3.1 is being targeted for Winter Break 2022. Steam system will be shut off after dismissal on December 16, 2022 and mobilization may begin on same day. Abatement shall commence as soon as pipes have cooled. Work shall be completed by or on December 30, 2022.

# All Remaining Work:

Anticipated start date is May 1, 2023 (approximate) and shall be completed by June 20, 2023 (approximate). Project phasing and schedule shall be closely coordinated with General Contractor, District, and Carnow Conibear.

DRAWING HISTORY					
NO.	DATE	DRAWN BY:	CHECKED BY:	REMARKS	
1	03/03/2022	M. Gomez	E. Christian	ISSUED FOR BID	

Rockford Public Schools 501 7th Street Rockford, Illinois 61104 Asbestos Abatement
Flinn Middle School
2525 Ohio Pkwy
Rockford, Illinois 61108

PROJECT DESIGNER

SHEET TITLE:

ASBESTOS ABATEMENT GENERAL NOTES ADDENDUM NO. 1

600 W. Van Buren St., Suite 500 Chicago, IL 60607 t: 312.782.4486 f: 312.782.5145 www.ccaltd.com

Carnow, Conibear & Assoc., Ltd.

**Environmental Consulting Services** 


CCA PROJECT NO.

PLOT DATE:
SEPTEMBER 23, 2022
SHEET NO.

ASB-G

John Dobby
IDPH #: 100-09261


John M. Dobby

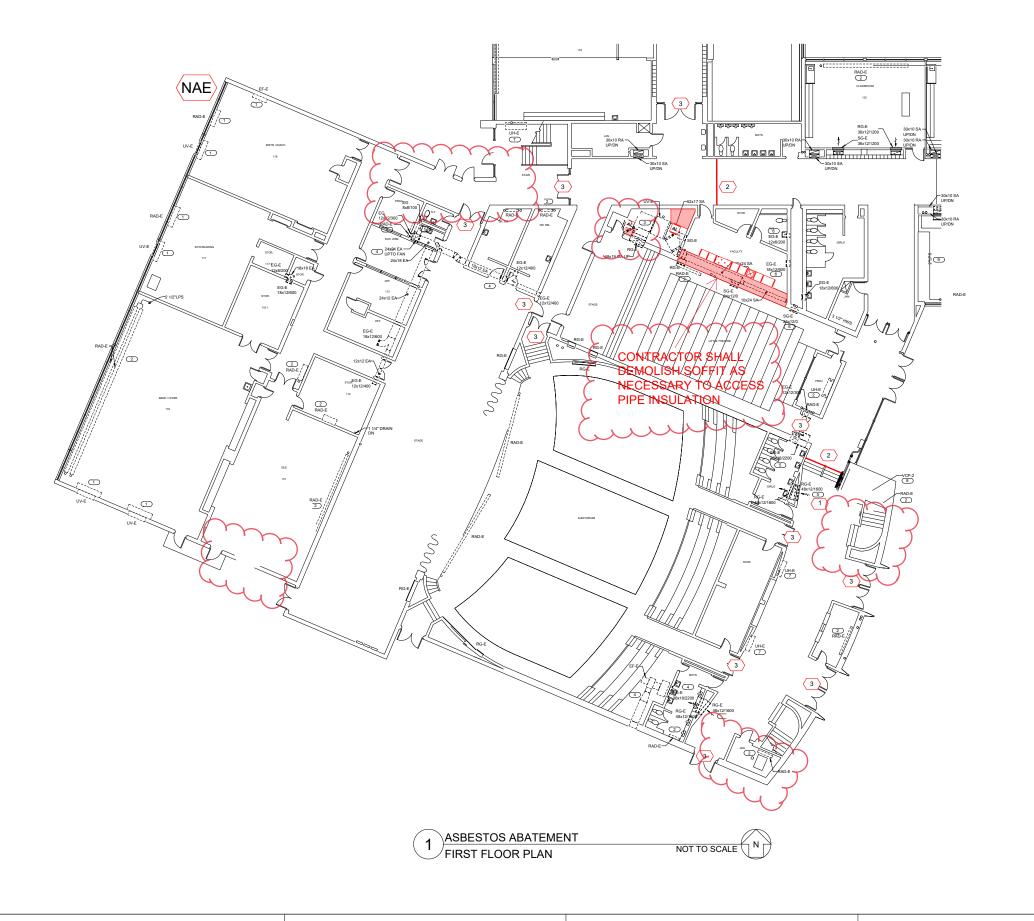

- 1. Mini-Enclosure Abatement of Pipe Insulation.
- 2. All work per Specification Section 02 131 applicable IDPH, IEPA and OSHA regulations.

ASBESTOS ABATEMENT KEYNOTES				
	Remote decontamination unit.			
AL	Airlock			
Separation barrier per IDPH 855.430(a)				
Separation barrier per IDPH 855.430(b) (with lockable do				
3	Contractor to secure door and control access			
	Remove thermal system insulation.			
* * * * * * * * * * * * * * * * * * *	Asbestos Abatement Containment Area. No removal in this area			
	Access Hatch			

# **KEY PLAN - FIRST FLOOR:**

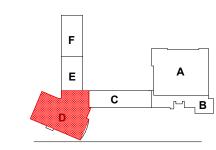

DRAWING HISTORY				
NO.	DATE	DRAWN BY:	CHECKED BY:	REMARKS
1	03/03/2022	M. Gomez	E. Christian	ISSUED FOR BID

Rockford Public Schools 501 7th Street Rockford, Illinois 61104 Asbestos Abatement
Flinn Middle School
2525 Ohio Pkwy
Rockford, Illinois 61108

John Dobby IDPH #: 100-09261

PROJECT DESIGNER

ASBESTOS ABATEMENT FIRST
PARTIAL PLAN SECTION D
ADDENDUM NO. 1

DESIGNER SIGNATURE

John M. Dobby

Carnow, Conibear & Assoc., Ltd.
Environmental Consulting Services
600 W. Van Buren St., Suite 500
Chicago, IL 60607
t: 312.782.4486 f: 312.782.5145
www.ccaltd.com

CCA PROJECT NO.

PLOT DATE:
SEPTEMBER 23, 2022
SHEET NO.

ASB-2

CARNOW CONIBEAR

# SCOPE OF WORK

#### **ASBESTOS ABATEMENT:**

- 1. Abatement of thermal systems pipe insulation with gross removal and mini-enclosure glovebag methods.
- 2. Work to be conducted per specification section 02131 and applicable IDPH, IEPA, and OSHA rules and regulations.

# BID ALLOWANCE (ALTERNATE #1):

Removal and disposal of pipe insulation using glovebag removal methods within minienclosures as needed by General Contractor. (The General Contractor shall be responsible for all demolition necessary to access the insulation. The bid allowance shall be a not-to-exceed cost and include the abatement of up to 250 linear feet of thermal system insulation from up to 10 mini-enclosures. Cost adjustments for addition or deductions will be made based on actual quantities and per price schedule. Price shall include one (1) mobilization.

# SCHEDULE:

Anticipated start date is May 1, 2023 (approximate and where feasible) and shall be completed by June 23, 2023 (approximate). Project phasing and schedule shall be closely coordinated with General Contractor, District, and Carnow Conibear.

# **GENERAL NOTES**

1. Locations shown are approximate only.

- 2. Phasing of the work to be determined by the General Contractor and the Building Owner.
- 3. Worker decontamination enclosure system shall be constructed in strict accordance with IDPH section 855.410. Clean room shall be sized to accommodate the needs of the work crew. Donning and doffing of PPE outside of clean room is strictly prohibited.
- 4. Where non-friable removal methods are utilized (Specification Section 3.11(D)), Contractor shall be responsible for the isolation of the work area(s) with critical seals, signage, and the security of the work areas to eliminate access by unauthorized personnel.

- 5. HEPA filtered negative air machines shall be set up within the work areas and run continuously through the completion of all work.
- 6. The abatement contractor is responsible for the lockout and tagout of all mechanical equipment prior to starting any mitigation/ abatement or O&M clean up in or on any equipment, etc.
- 7. The contractor is responsible for verifying quantities in the field before bidding. Any questions about the scope or clarifications shall be obtained from the Project Designer prior to bidding. Any interpretations of the design documents shall only be made by the Project Designer. The abatement contractor shall be responsible for removing any ACM which will be disturbed during renovation activities, prior to renovation activities.
- 8. When a room or location identified on an environmental scope of work sheet, all closets, bathrooms, offices, storage rooms, etc. are included in the scope of work for that room or location.
- 9. The abatement contractor is responsible for all security to the work area(s) during the environmental mitigation/abatement and replacement activities. The abatement contractor shall be responsible for any damages or thefts to property in the work area(s), until the area(s) are returned to the property owner. The abatement contractor shall repair and/or replace damaged or stolen property to the satisfaction of, and at no additional cost to the property owner.
- 10. Electric/HVAC service shall be disconnected by the District as necessary.
- 11. Any existing electrical panels in the work area shall be adequately protected (i.e. "Boxed out.") during Asbestos Abatement activities in accordance with specification 02131 and all applicable regulations.
- 12. Contractor shall maintain clear access to building egress points outside of regulated areas.
- 13. The School District will provide an electrician for the installation of temporary power panels and/or whips and isolation of work areas. The Abatement Contractor is responsible for providing District electrician any power panels and/or whips a minimum of five (5) business days prior to start of work. Coordinate with Carnow Conibear.
- 14. If abatement of flooring materials is specified, the Abatement Contractor is responsible for the removal of all layers of flooring, associated mastics, and leveling compounds down to the lowest substrate. Unless specified, NO CHEMICAL REMOVAL OF MASTICS shall be utilized. Mechanical removal methods ONLY.
- 15. Contractor Supervisor is required to perform a punch list walk-through with a Carnow Conibear representative prior to containment tear-down AND demobilization to ensure all scope items have been removed, project specifications are met, and any incidental damage is identified.
- 16. Contractor shall remove dumpster from site within two (2) weeks of project completion. District may seek damages of \$500/day for dumpsters not removed.

	DRAWING HISTORY					
	NO.	DATE	DRAWN BY:	CHECKED BY:	REMARKS	
	1	03/03/2022	M. Gomez	E. Christian	ISSUED FOR BID	
Г						

Rockford Public Schools #205 501 7th Street Rockford, IL 61104 Asbestos Abatement
Washington Elementary School
1421 West St
Rockford, IL 61102

Rod Harvey

IDPH #: 100-01548

PROJECT DESIGNER

SHEET TITLE:

ASBESTOS ABATEMENT GENERAL NOTES ADDENDUM #1


Carnow, Conibear & Assoc., Ltd.
Environmental Consulting Services
600 W. Van Buren St., Suite 500
Chicago, IL 60607
t: 312.782.4486 f: 312.782.5145
www.ccaltd.com

PLOT DATE:
SEPTEMBER 23, 2022
SHEET NO.

**ASB-G** 

DESIGNER SIGNATURE


IL 60607 782.5145 altd.com CARNOW CONIBEAR

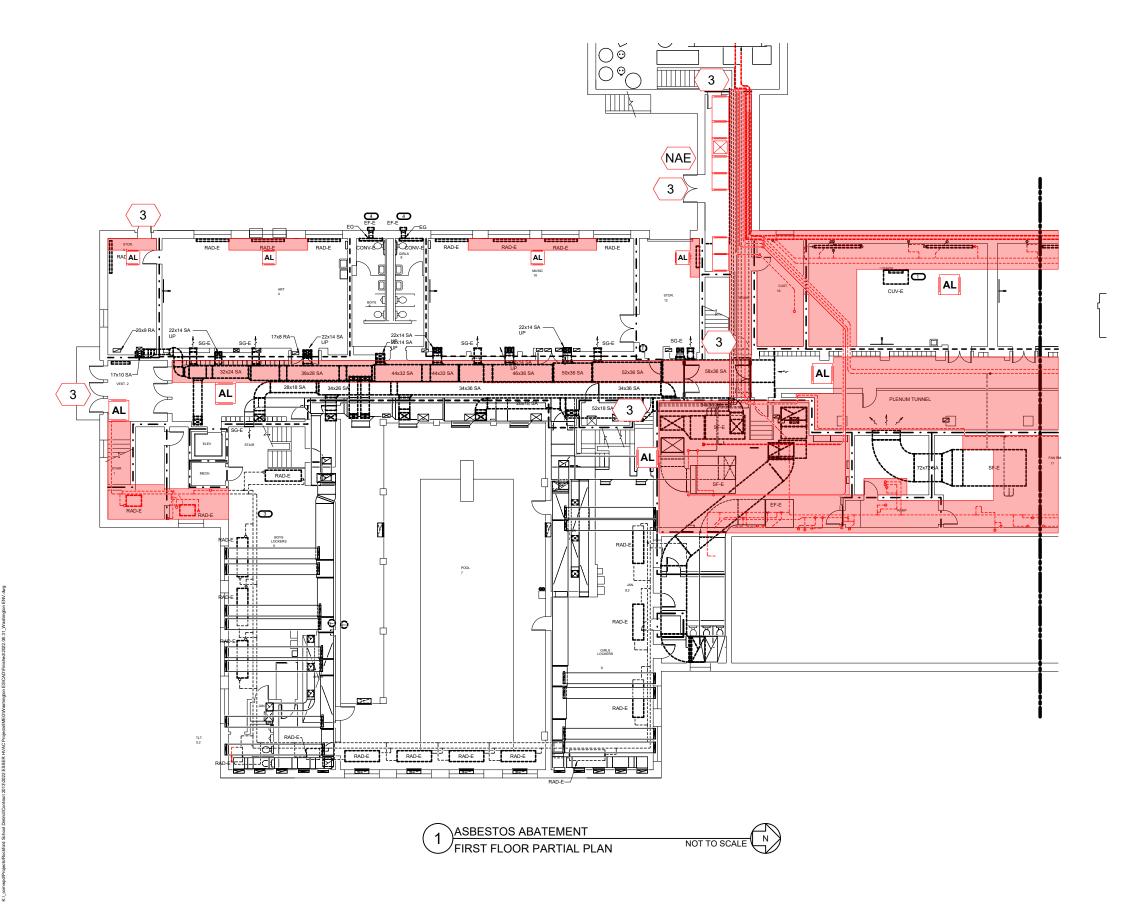

- 1. Mini-Enclosure and gross removal of pipe insulation.
- 2. Demolition of wood riser guards, ceilings, or walls as necessary to access piping scheduled for removal per AOR drawings.
- 3. All work per Specification Section 02131 applicable IDPH, IEPA and OSHA

ASBESTOS ABATEMENT KEYNOTES			
	Remote decontamination unit.		
AL	Airlock		
Separation barrier per IDPH 855.430(a)			
2	Separation barrier per IDPH 855.430(b) (with lockable door		
3	Contractor to secure door and control access		
	Remove thermal system insulation.		
* * * * * * * * * * * * * * * * * * *	Asbestos Abatement Containment Area. No removal in this area		

#### **KEY PLAN - FIRST FLOOR:**

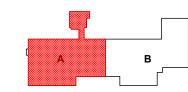

DRAWING HISTORY					
NO.	DATE	DRAWN BY:	CHECKED BY:	REMARKS	
1	03/03/2022	M. Gomez	E. Christian	ISSUED FOR BID	

**Rockford Public Schools #205** 501 7th Street Rockford, IL 61104

**Asbestos Abatement** Washington Elementary School 1421 West St Rockford, IL 61102

> Rod Harvey IDPH #: 100-01548

PROJECT DESIGNER


SHEET TITLE:

**ASBESTOS ABATEMENT** FIRST FLOOR PLAN ADDENDUM #1

Carnow, Conibear & Assoc., Ltd. **Environmental Consulting Services** 600 W. Van Buren St., Suite 500 Chicago, IL 60607 t: 312.782.4486 f: 312.782.5145 www.ccaltd.com

CCA PROJECT NO. PLOT DATE: SEPTEMBER 23, 2022


**CARNOW CONIBEAR** ASB-1

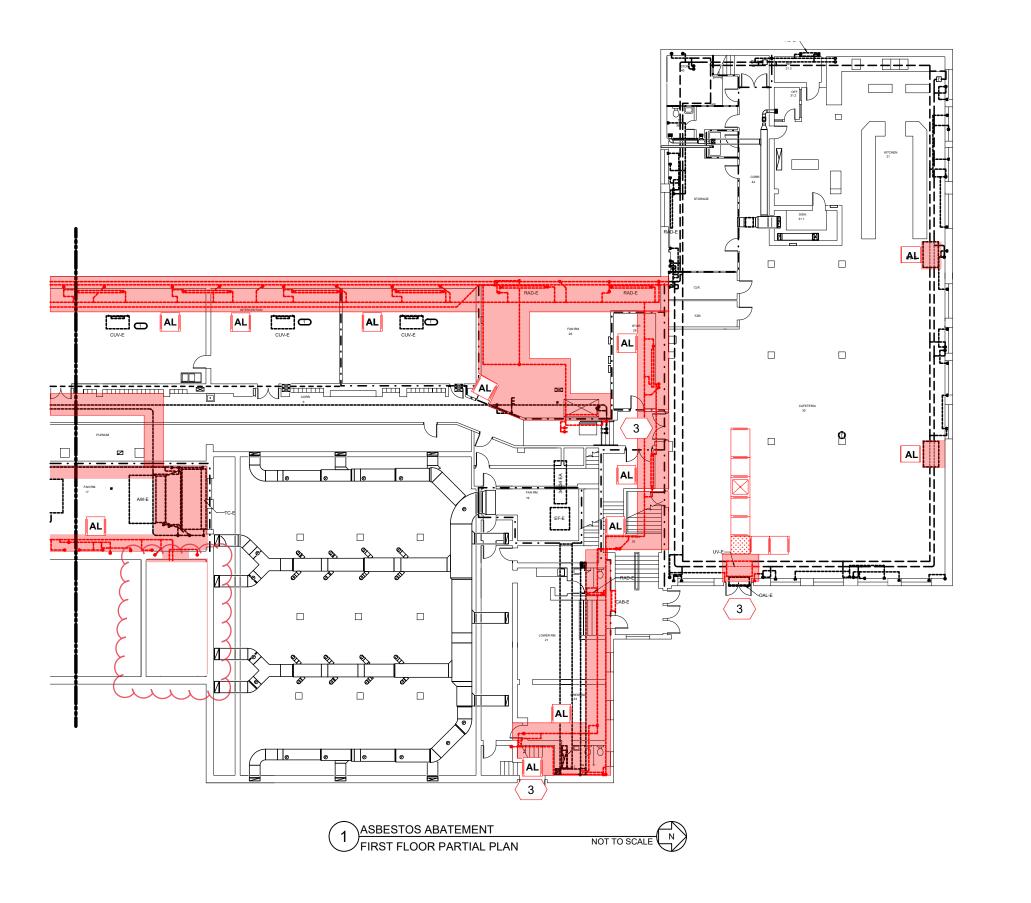

- 1. Mini-Enclosure and gross removal of pipe insulation.
- Demolition of wood riser guards, ceilings, or walls as necessary to access piping scheduled for removal per AOR drawings.
- 3. All work per Specification Section 02131 applicable IDPH, IEPA and OSHA regulations.

ASBESTOS A	ASBESTOS ABATEMENT KEYNOTES			
Remote decontamination unit.				
Waste Out				
Al Airlock				
Separation barrier per IDPH 855.430(a)				
Separation barrier per IDPH 855.430(b) (with lockable doo				
3	Contractor to secure door and control access			
	Remove thermal system insulation.			
* + + + + + + + + + + + + + + + + + + +	Asbestos Abatement Containment Area. No removal in this area			

# **KEY PLAN - FIRST FLOOR:**

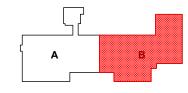

DRAWING HISTORY					
NO.	DATE	DRAWN BY:	CHECKED BY:	REMARKS	
1	03/03/2022	M. Gomez	E. Christian	ISSUED FOR BID	

Rockford Public Schools #205 501 7th Street Rockford, IL 61104 Asbestos Abatement
Washington Elementary School
1421 West St
Rockford, IL 61102

Rod Harvey IDPH #: 100-01548

PROJECT DESIGNER

ASBESTOS ABATEMENT
FIRST FLOOR PLAN
ADDENDUM #1


Carnow, Conibear & Assoc., Ltd.
Environmental Consulting Services
600 W. Van Buren St., Suite 500
Chicago, IL 60607
t: 312.782.4486 f: 312.782.5145
www.ccaltd.com

CAPNOW

CCA PROJECT NO.

PLOT DATE:
SEPTEMBER 23, 2022
SHEET NO.

CARNOW ASB-2

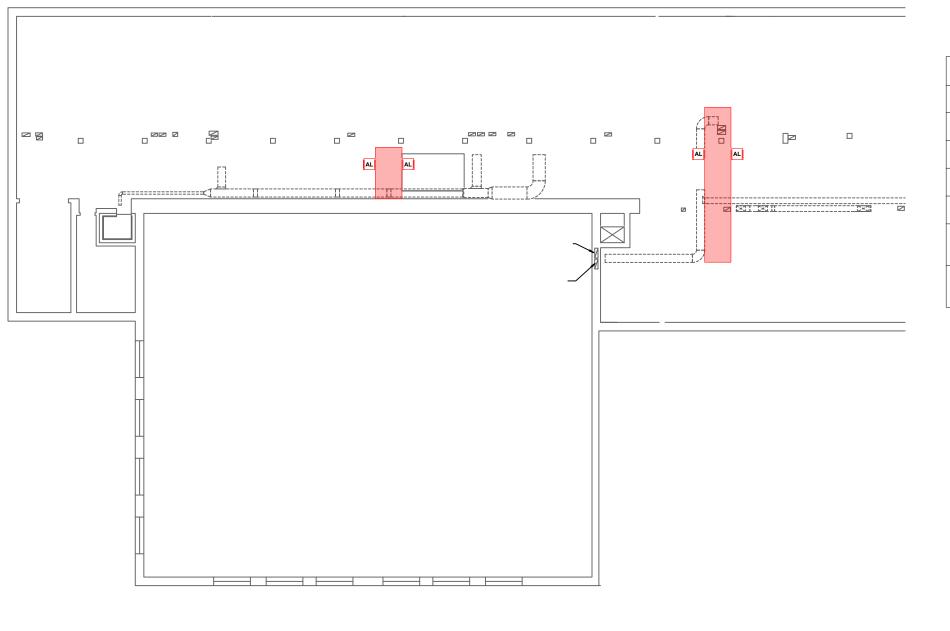

- 1. Mini-Enclosure and gross removal of pipe insulation.
- 2. Demolition of wood riser guards, ceilings, or walls as necessary to access piping scheduled for removal per AOR drawings.
- 3. All work per Specification Section 02131 applicable IDPH, IEPA and OSHA

ASBESTOS ABATEMENT KEYNOTES				
	Remote decontamination unit.			
Airlock				
Separation barrier per IDPH 855.430(a)				
2	Separation barrier per IDPH 855.430(b) (with lockable door)			
3	Contractor to secure door and control access			
	Approximate Location of Mini-Enclosures and Piping			
* + + + + + + + + + + + + + + + + + + +	Asbestos Abatement Containment Area. No removal in this area			

# **KEY PLAN - ATTIC FLOOR:**



	DRAWING HISTORY						
NO.	DATE	DRAWN BY:	CHECKED BY:	REMARKS			
1 03	03/2022	M. Gomez	E. Christian	ISSUED FOR BID			

**Rockford Public Schools #205** 501 7th Street Rockford, IL 61104

ASBESTOS ABATEMENT ATTIC FLOOR PARTIAL PLAN

> **Asbestos Abatement** Washington Elementary School 1421 West St Rockford, IL 61102

> > Rod Harvey IDPH #: 100-01548

PROJECT DESIGNER


ASBESTOS ABATEMENT

ATTIC FLOOR PLAN - AREA A ADDENDUM #1

Carnow, Conibear & Assoc., Ltd. **Environmental Consulting Services** 600 W. Van Buren St., Suite 500 Chicago, IL 60607 t: 312.782.4486 f: 312.782.5145 www.ccaltd.com

CCA PROJECT NO. SEPTEMBER 23, 2022


**CARNOW CONIBEAR** ASB-3

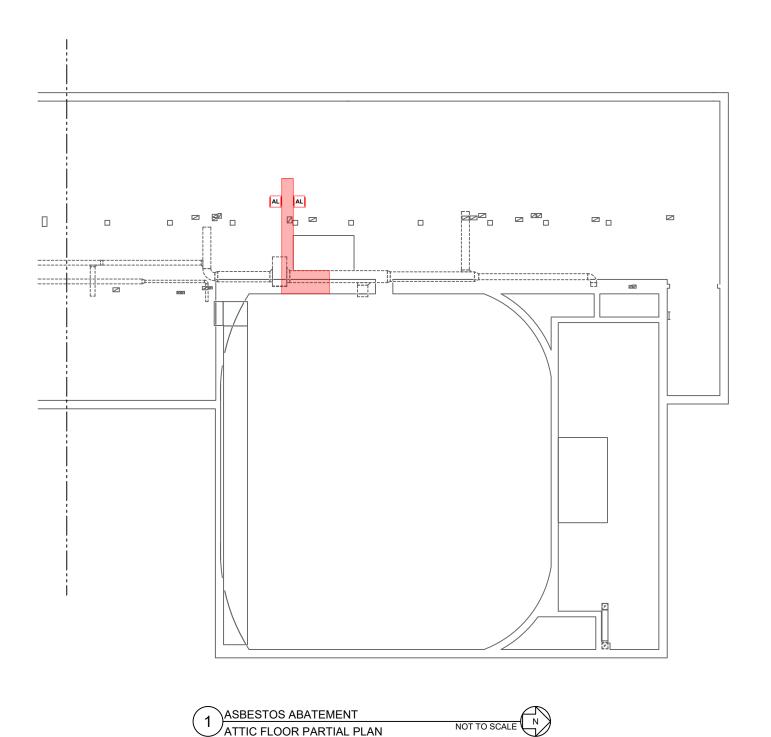

- 1. Mini-Enclosure and gross removal of pipe insulation.
- 2. Demolition of wood riser guards, ceilings, or walls as necessary to access piping scheduled for removal per AOR drawings.
- 3. All work per Specification Section 02131 applicable IDPH, IEPA and OSHA regulations.

ASBESTOS ABATEMENT KEYNOTES			
Remote decontamination unit.			
Airlock			
Separation barrier per IDPH 855.430(a)			
2	Separation barrier per IDPH 855.430(b) (with lockable door)		
3	Contractor to secure door and control access		
	Approximate Location of Mini-Enclosures and Piping		
† + + + + + + + + + + + + + + + + + + +	Asbestos Abatement Containment Area. No removal in this area		

# **KEY PLAN - ATTIC FLOOR:**

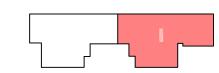

	DRAWING HISTORY				
NO.	DATE	DRAWN BY:	CHECKED BY:	REMARKS	
1 03	/03/2022	M. Gomez	E. Christian	ISSUED FOR BID	

Rockford Public Schools #205 501 7th Street Rockford, IL 61104

CLIENT:

Asbestos Abatement
Washington Elementary School
1421 West St
Rockford, IL 61102

Rod Harvey IDPH #: 100-01548

PROJECT DESIGNER

ASBESTOS ABATEMENT
ATTIC FLOOR PLAN - AREA B
ADDENDUM #1

C FLOOR PLAN - AREA B


ADDENDUM #1

Carnow, Conibear & Assoc., Ltd.
Environmental Consulting Services
600 W. Van Buren St., Suite 500
Chicago, IL 60607
t: 312.782.4486 f: 312.782.5145
www.ccaltd.com

CCA PROJECT NO.

PLOT DATE:
SEPTEMBER 23, 2022


CARNOW CONIBEAR ASB-4

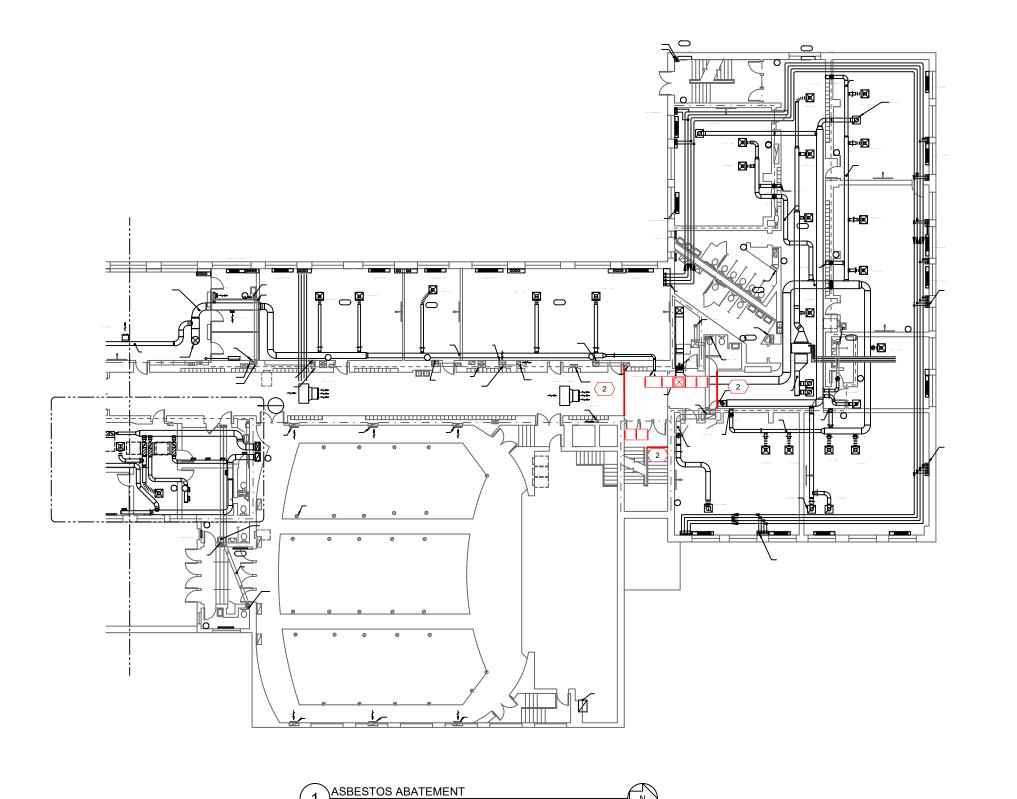

- 1. Mini-Enclosure and gross removal of pipe insulation.
- 2. Demolition of wood riser guards, ceilings, or walls as necessary to access piping scheduled for removal per AOR drawings.
- 3. All work per Specification Section 02131 applicable IDPH, IEPA and OSHA regulations.

ASBESTOS A	ASBESTOS ABATEMENT KEYNOTES			
Remote decontamination unit.				
Waste Out				
Airlock				
Separation barrier per IDPH 855.430(a)				
Separation barrier per IDPH 855.430(b) (with lockable doc				
Contractor to secure door and control access				
	Approximate Location of Mini-Enclosures and Piping			
* * * * * * * * * * * * * * * * * * *	Asbestos Abatement Containment Area. No removal in this area			

# **KEY PLAN - SECONDE FLOOR:**

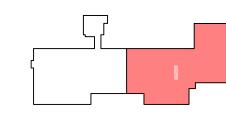

	DRAWING HISTORY					
NO.	DATE	DRAWN BY:	CHECKED BY:	REMARKS		
1 03	/03/2022	M. Gomez	E. Christian	ISSUED FOR BID		
					i	

**Rockford Public Schools #205** 501 7th Street Rockford, IL 61104

SECOND FLOOR PARTIAL PLAN

**Asbestos Abatement** Washington Elementary School 1421 West St Rockford, IL 61102

> Rod Harvey IDPH #: 100-01548


PROJECT DESIGNER

ASBESTOS ABATEMENT SECOND FLOOR PLAN - AREA B ADDENDUM #1

Carnow, Conibear & Assoc., Ltd.
Environmental Consulting Services
600 W. Van Buren St., Suite 500
Chicago, IL 60607
t: 312.782.4486 f: 312.782.5145
www.ccaltd.com

CCA PROJECT NO. SEPTEMBER 23, 2022


**CARNOW CONIBEAR** ASB-5

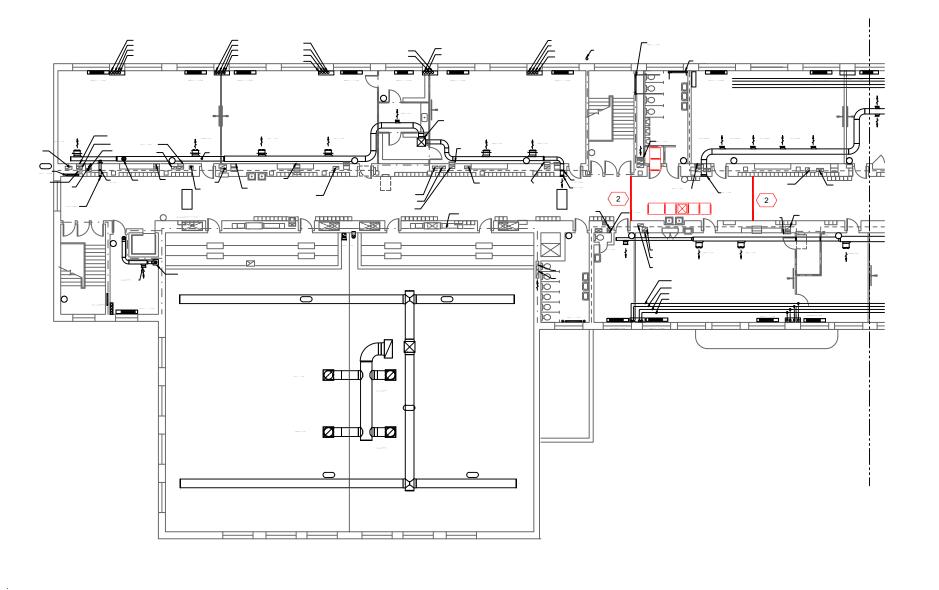

- 1. Mini-Enclosure and gross removal of pipe insulation.
- 2. Demolition of wood riser guards, ceilings, or walls as necessary to access piping scheduled for removal per AOR drawings.
- All work per Specification Section 02131 applicable IDPH, IEPA and OSHA regulations.

ASBESTOS A	ASBESTOS ABATEMENT KEYNOTES			
Remote decontamination unit.				
	Waste Out			
Airlock				
Separation barrier per IDPH 855.430(a)				
Separation barrier per IDPH 855.430(b) (with lockable door				
Contractor to secure door and control access				
	Approximate Location of Mini-Enclosures and Piping			
+ + + + + + + + + + + + + + + + + + +	Asbestos Abatement Containment Area. No removal in this area			

# **KEY PLAN - THIRD FLOOR:**

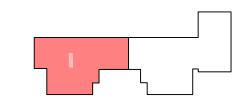

	DRAWING HISTORY						
NO.	DATE	DRAWN BY:	CHECKED BY:	REMARKS			
1	03/03/2022	M. Gomez	E. Christian	ISSUED FOR BID			

Rockford Public Schools #205 501 7th Street Rockford, IL 61104

ASBESTOS ABATEMENT
THIRD FLOOR PARTIAL PLAN

Asbestos Abatement
Washington Elementary School
1421 West St
Rockford, IL 61102

Rod Harvey IDPH #: 100-01548

PROJECT DESIGNER

ASBESTOS ABATEMENT
THIRD FLOOR PLAN - AREA A

ADDENDUM #1 t: 312.782.4486 f: 312.www.

Carnow, Conibear & Assoc., Ltd.
Environmental Consulting Services
600 W. Van Buren St., Suite 500
Chicago, IL 60607
t: 312.782.4486 f: 312.782.5145
www.ccaltd.com

PLOT DATE:
SEPTEMBER 23, 2022

CARNOW ASB-6

ROCKFORD PUBLIC SCHOOLS IFB No. 23-26 Asbestos Abatement at West M.S. Pre-Bid Meeting Sign-In Sheet September 20, 2022 at 10:00 a.m.



# PRE-BID MEETING SIGN-IN SHEET

IFB No. 23-26 Asbestos Abatement at West M.S. and IFB No. 23-27 Abatement at Washington, Clina and East
PLEASE WRITE EMAIL ADDRESS SO THAT IT IS LEGIBLE IN ORDER TO RECEIVE ADDENDUM INFORMATION

	PLEASE WRITE EMAIL ADDRESS SO THAT IT IS LEGIBLE IN ORDER TO RECEIVE ADDENDOM INFORMATION								
	Printed Name	Company Name	Company Address	Telephone	E-mail				
1	KEUIN MURRY	ate	The Tollow HA Be Warrely	841.506-9515	KMURN TO EHCENCLUSMICE				
2	Jehn Gordina	DEM Services	1765 countard cut	708-544-2244	demo demservices, co				
3	Robert Boll	colfex Corp.	duyl W. Leguitt st chicago, Ih 6064)	708-481-4170	Iboll@altonConnet				
4	Steve Zuchaik	Luse	3990 Enterprise Court Aurora, IL	630-913-9841	szuchniteins con				
	Joe Rodriguez	Kinsale	648 Blackhawk dr Westmont IL	(847)924-6356	soer@Kinsalecg.com				
	Paul Middleson		billsets, 12 60136		Paul @ Mbol Plas Sarrices				
7	Tomasz Stopow Su	Hosor Abatement lld	10216 E 112 Ac	7084839271	James 2. huse. L				

ROCKFORD PUBLIC SCHOOLS
IFB No. 23-26 Asbestos Abatement at West M.S.
Pre-Bid Meeting Sign-In Sheet
September 20, 2022 at 10:00 a.m.

			September 20, 2022 at 10:00 a.m.			
	Printed Name	Company Name	Company Address	Telephone	E-mail	
			195 INDUSTRIAUE			
8	RYAN FETE	NES	FRANKFORT, IL 60423	708-478-5497	rfe. O reservionmental, cor	
۵	A			Culp		
	KEVIN	IIIS	926 NOWTHSHOUS DR LINKS BLUEF TL	847 708 9153	KMCKINAFIL Q TFDM. CON	
10	Tono	III-S IFS	11	847-477.5416	+ jabandisspor.com	
11					J	
12						
13	3					
14	•					
15	5					
10	6					
1	7					
1	8					
1	9					